


TOTAL SF AVAILABLE -1,142 RSF RSF(12%)



Key Plan

[Click to access 3D model](#)

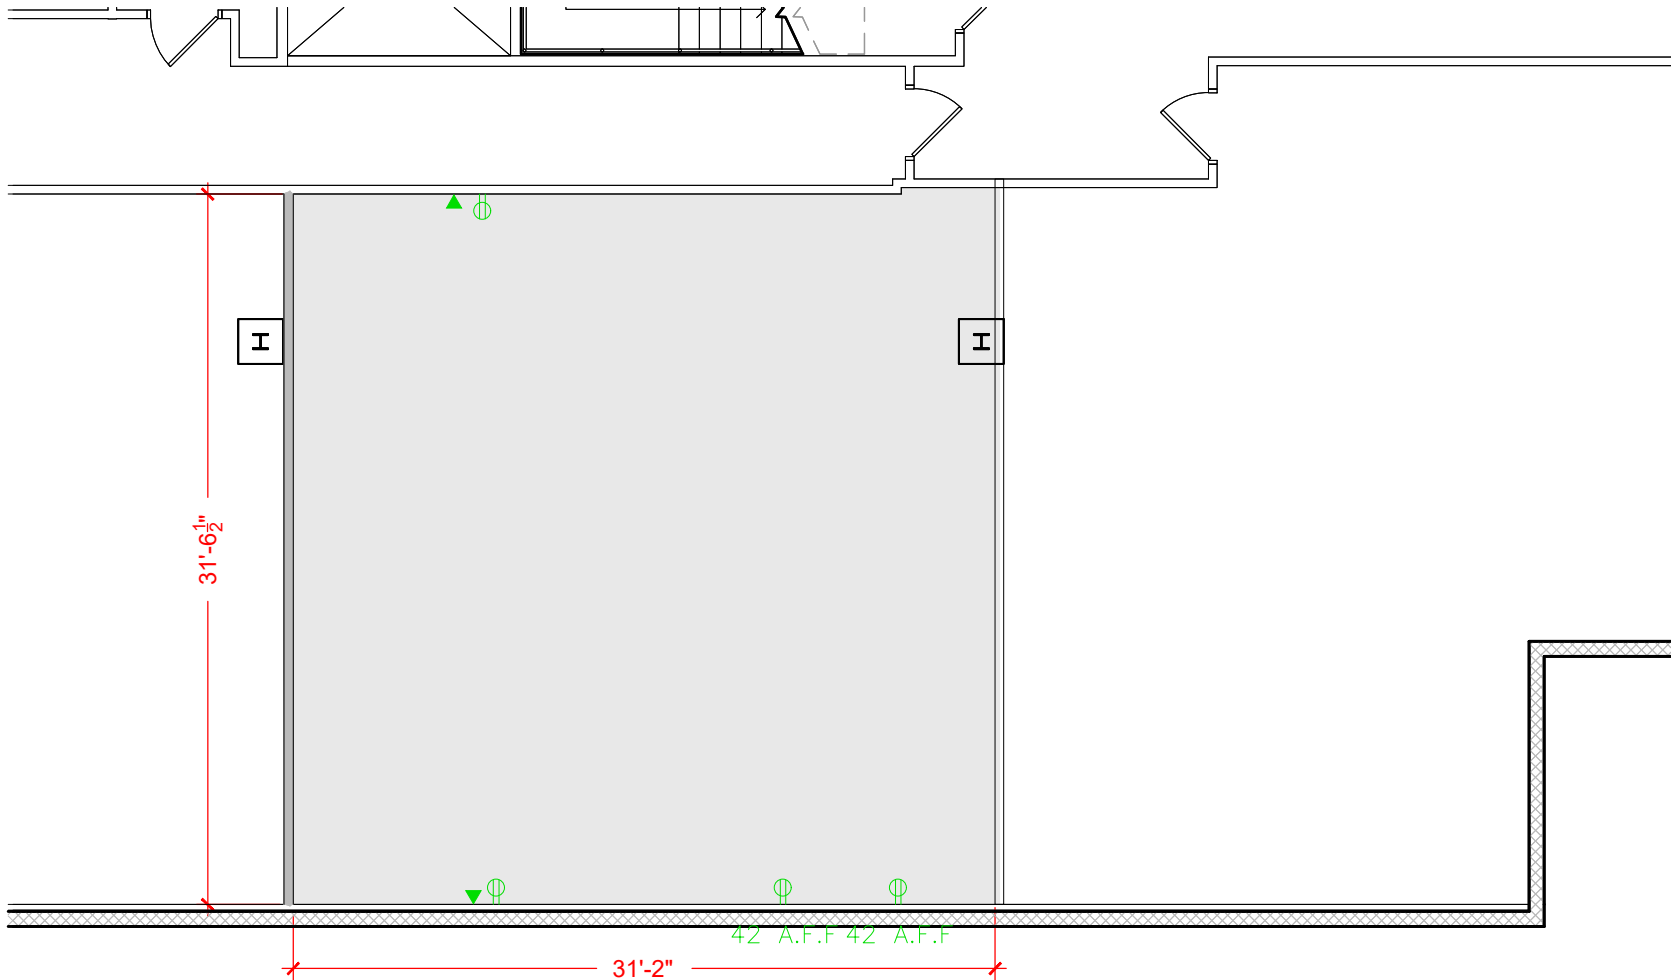

Floor Plan