



TOTAL SF AVAILABLE -1,102 RSF RSF(12%)

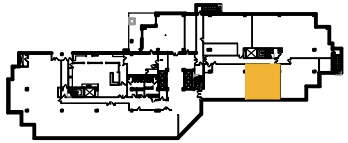

Key Plan

[Click to access CADD file](#)

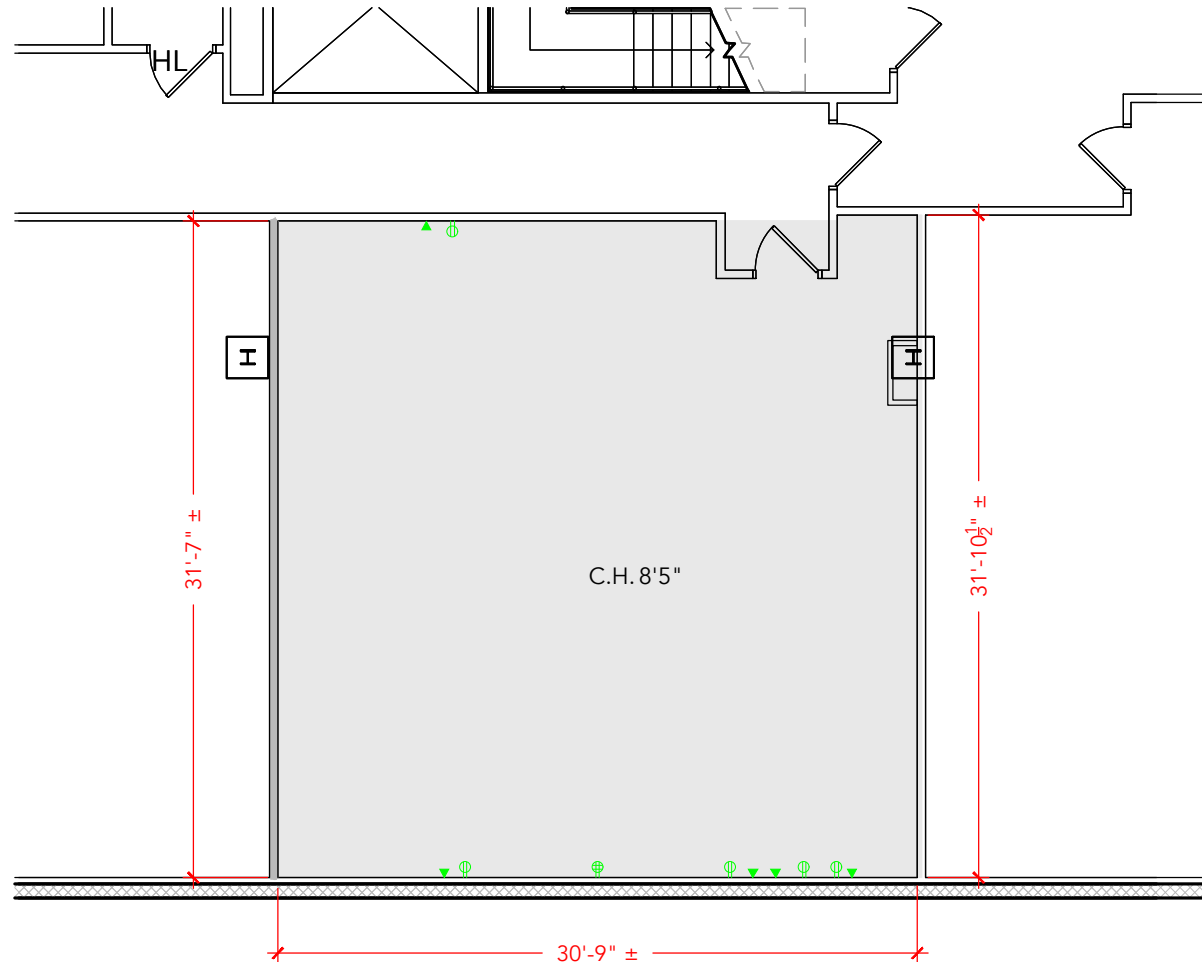

Floor Plan