


TOTAL SF AVAILABLE -1,427 RSF (12%)

[Click to access CADD file](#)

Key Plan

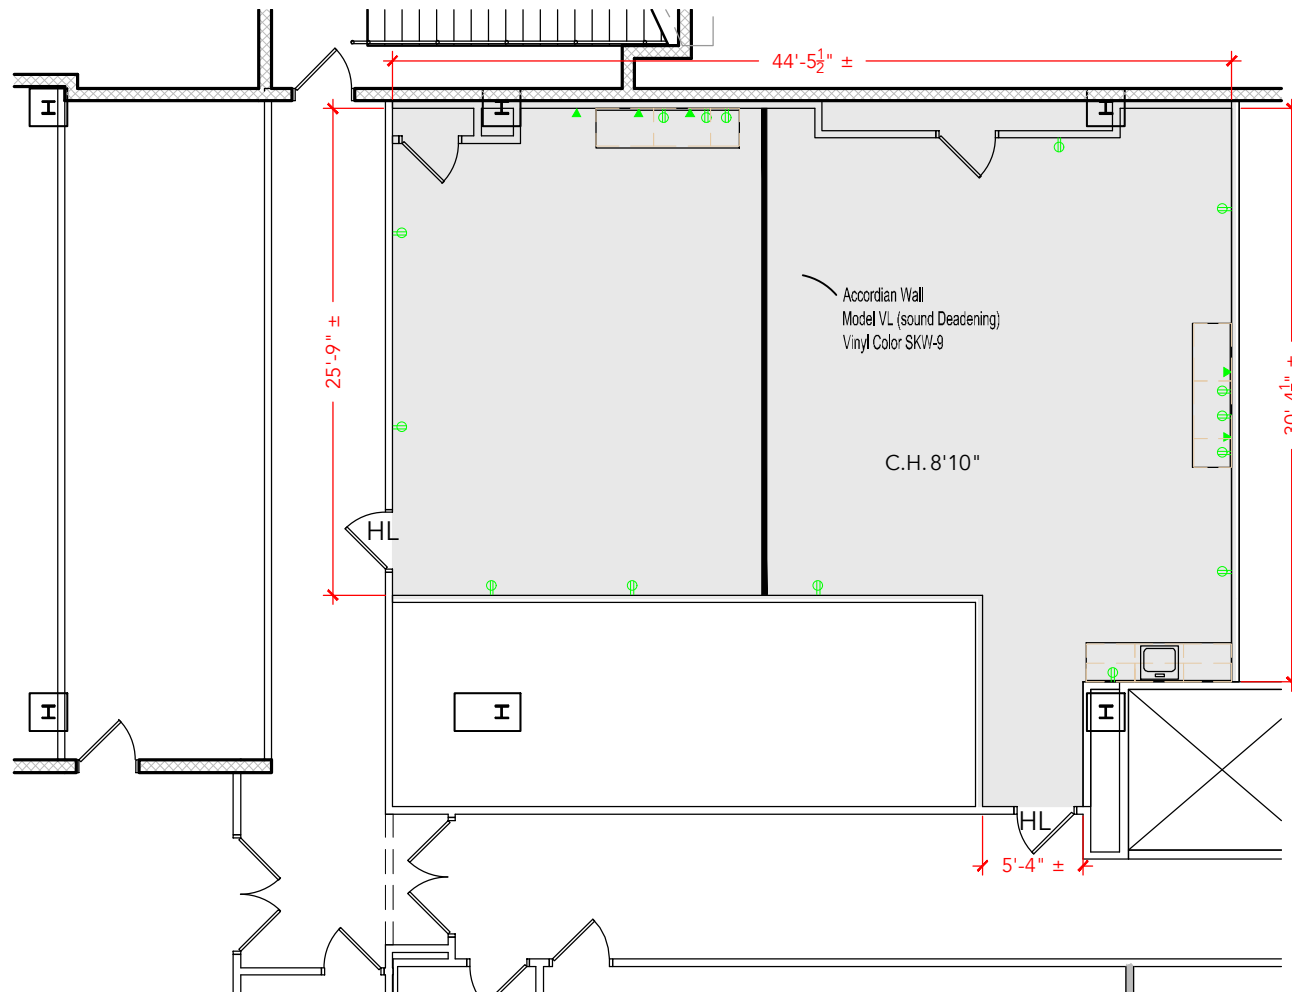

Floor Plan