



TOTAL SF AVAILABLE - 3,874 RSF(12%)

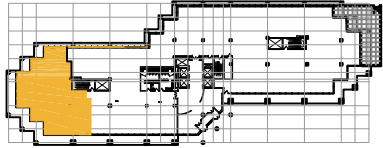

Key Plan

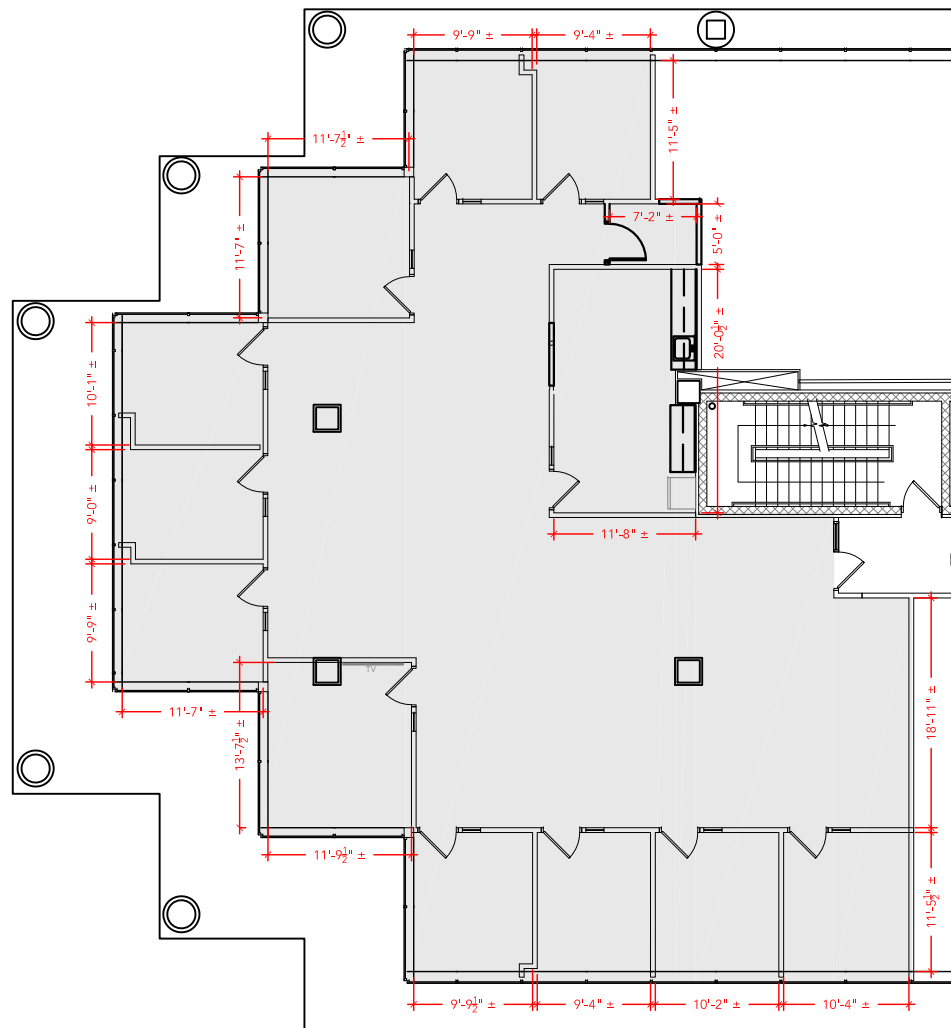

Floor Plan