


Key Plan

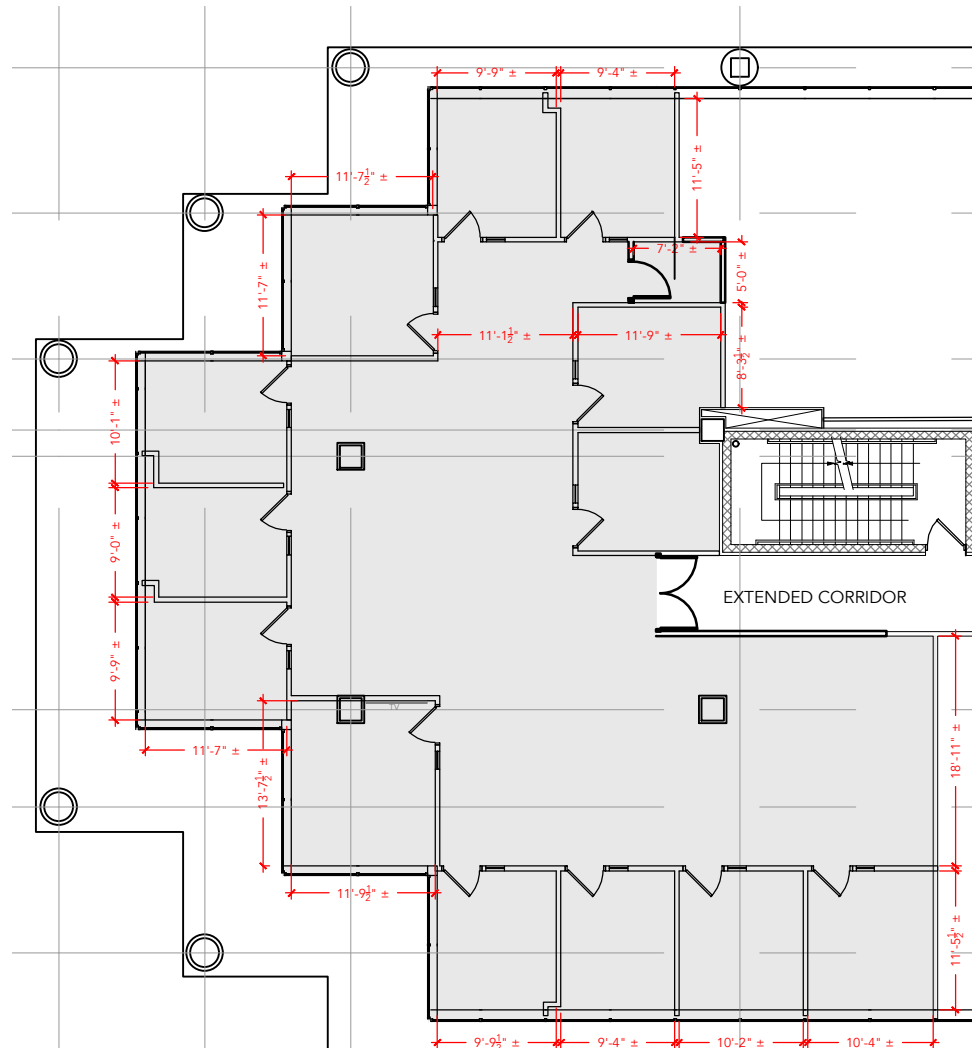

Floor Plan