


TOTAL SF AVAILABLE -5,184 RSF(12%)



[Click to access CADD file](#)

Key Plan

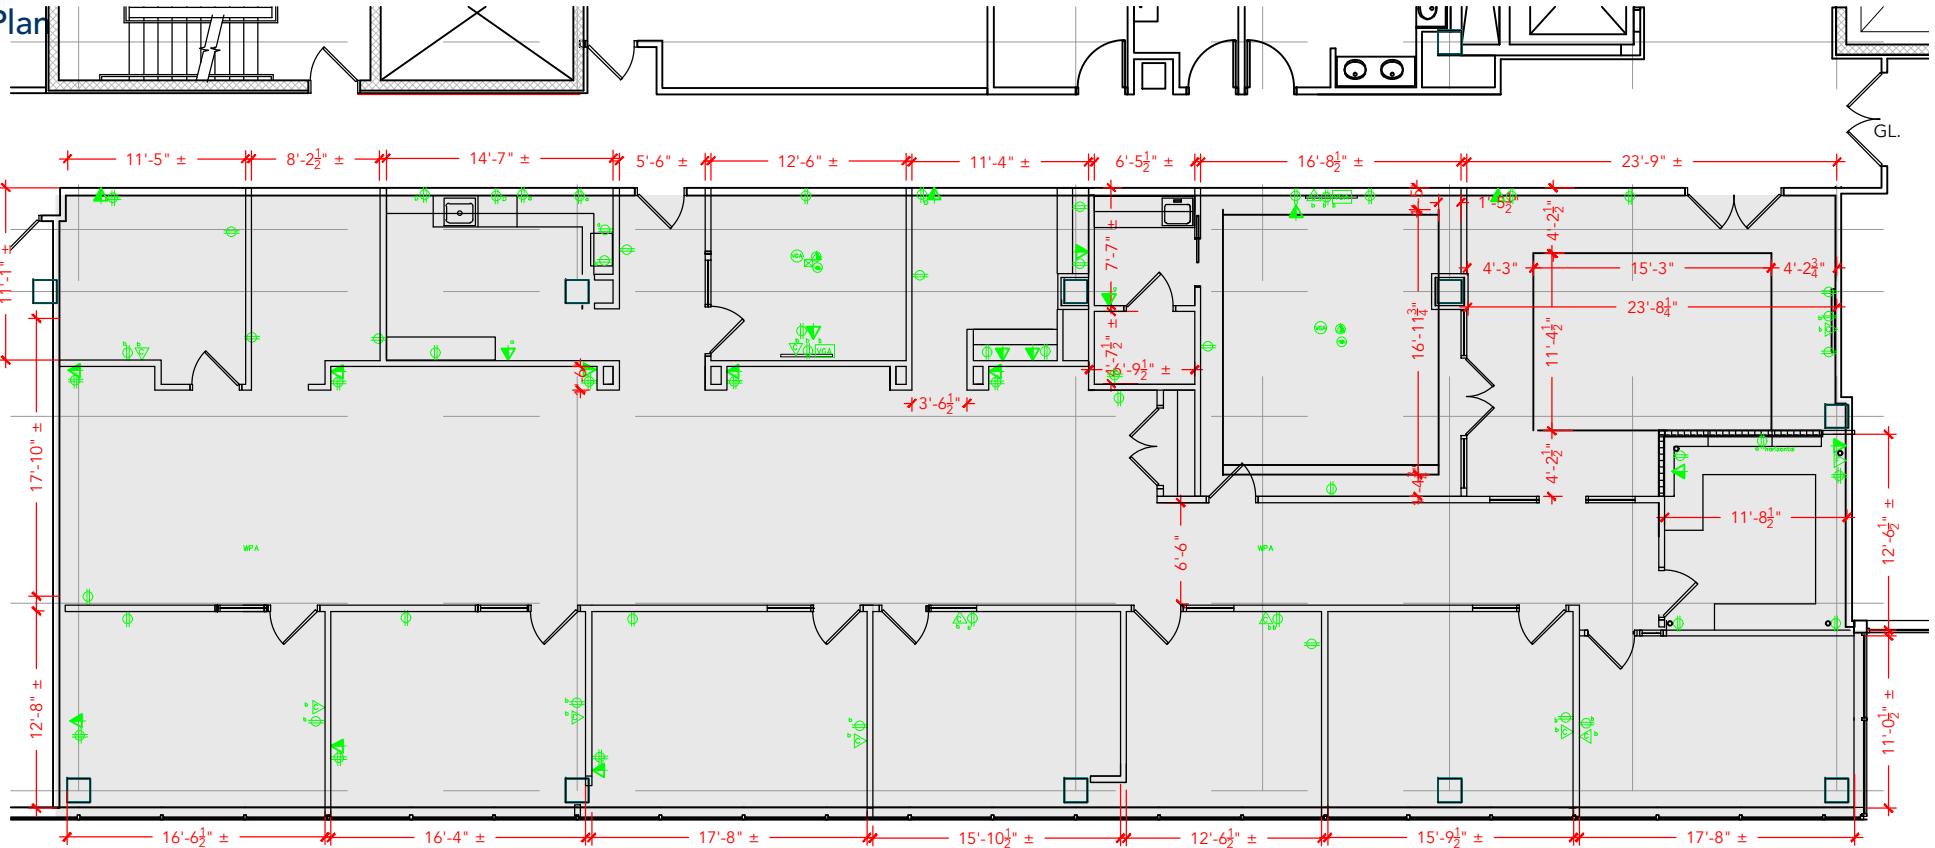

Floor Plan