


TOTAL SF AVAILABLE -3,219 RSF (12%)



[Click to access CADD file](#)

Key Plan

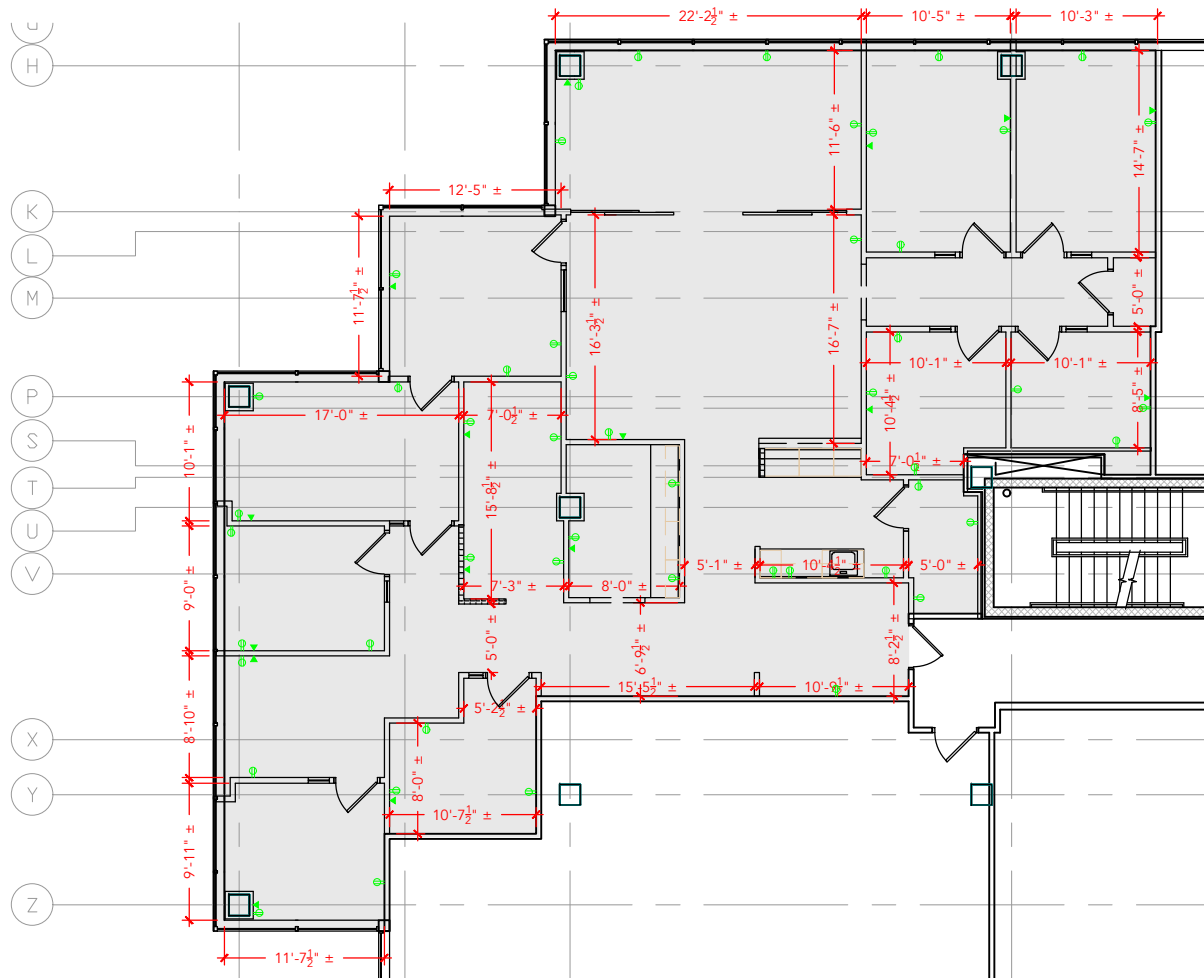

Floor Plan