


TOTAL SF AVAILABLE - 2,941 RSF(12%)

[Click to access 3D model](#)

Key Plan

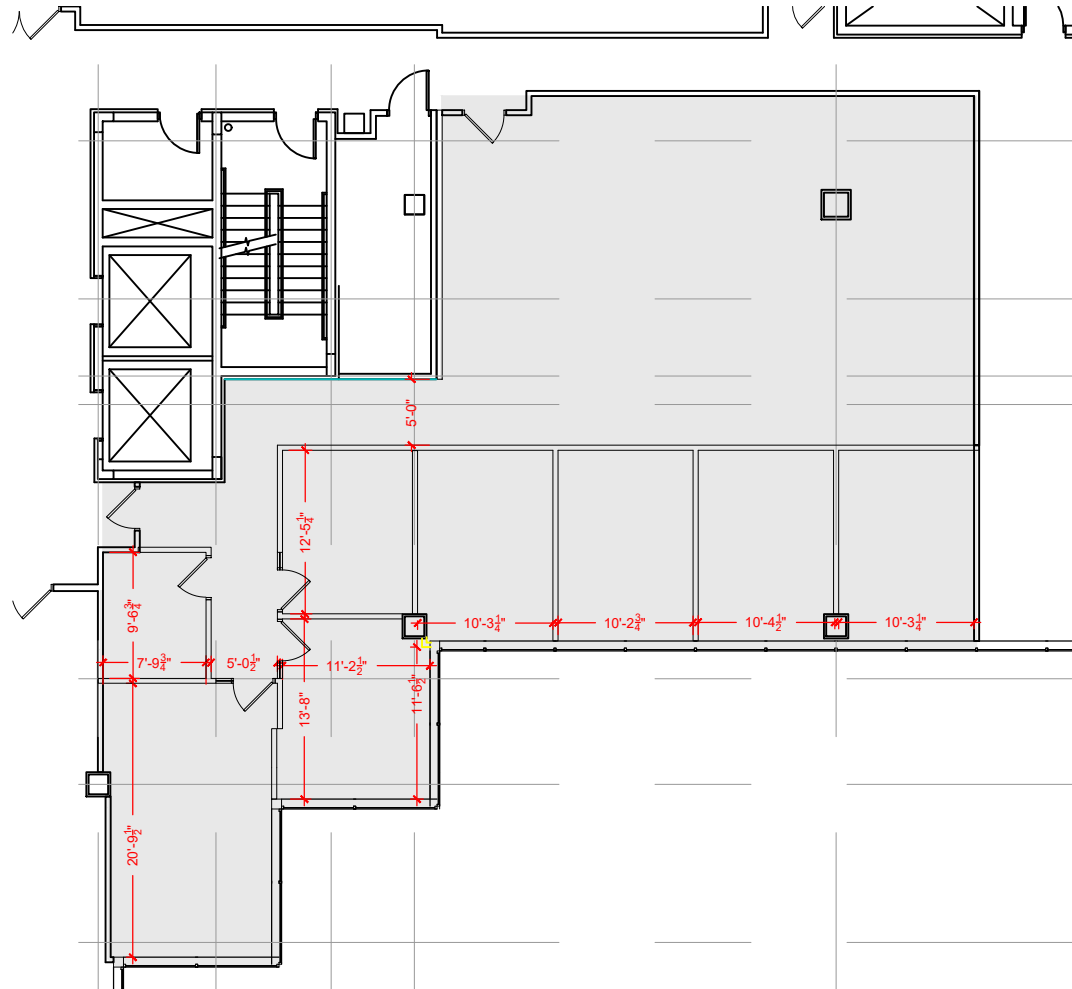

Floor Plan