


TOTAL SF AVAILABLE - 3,021 RSF(12%)



Key Plan

[Click to access 3D model](#)

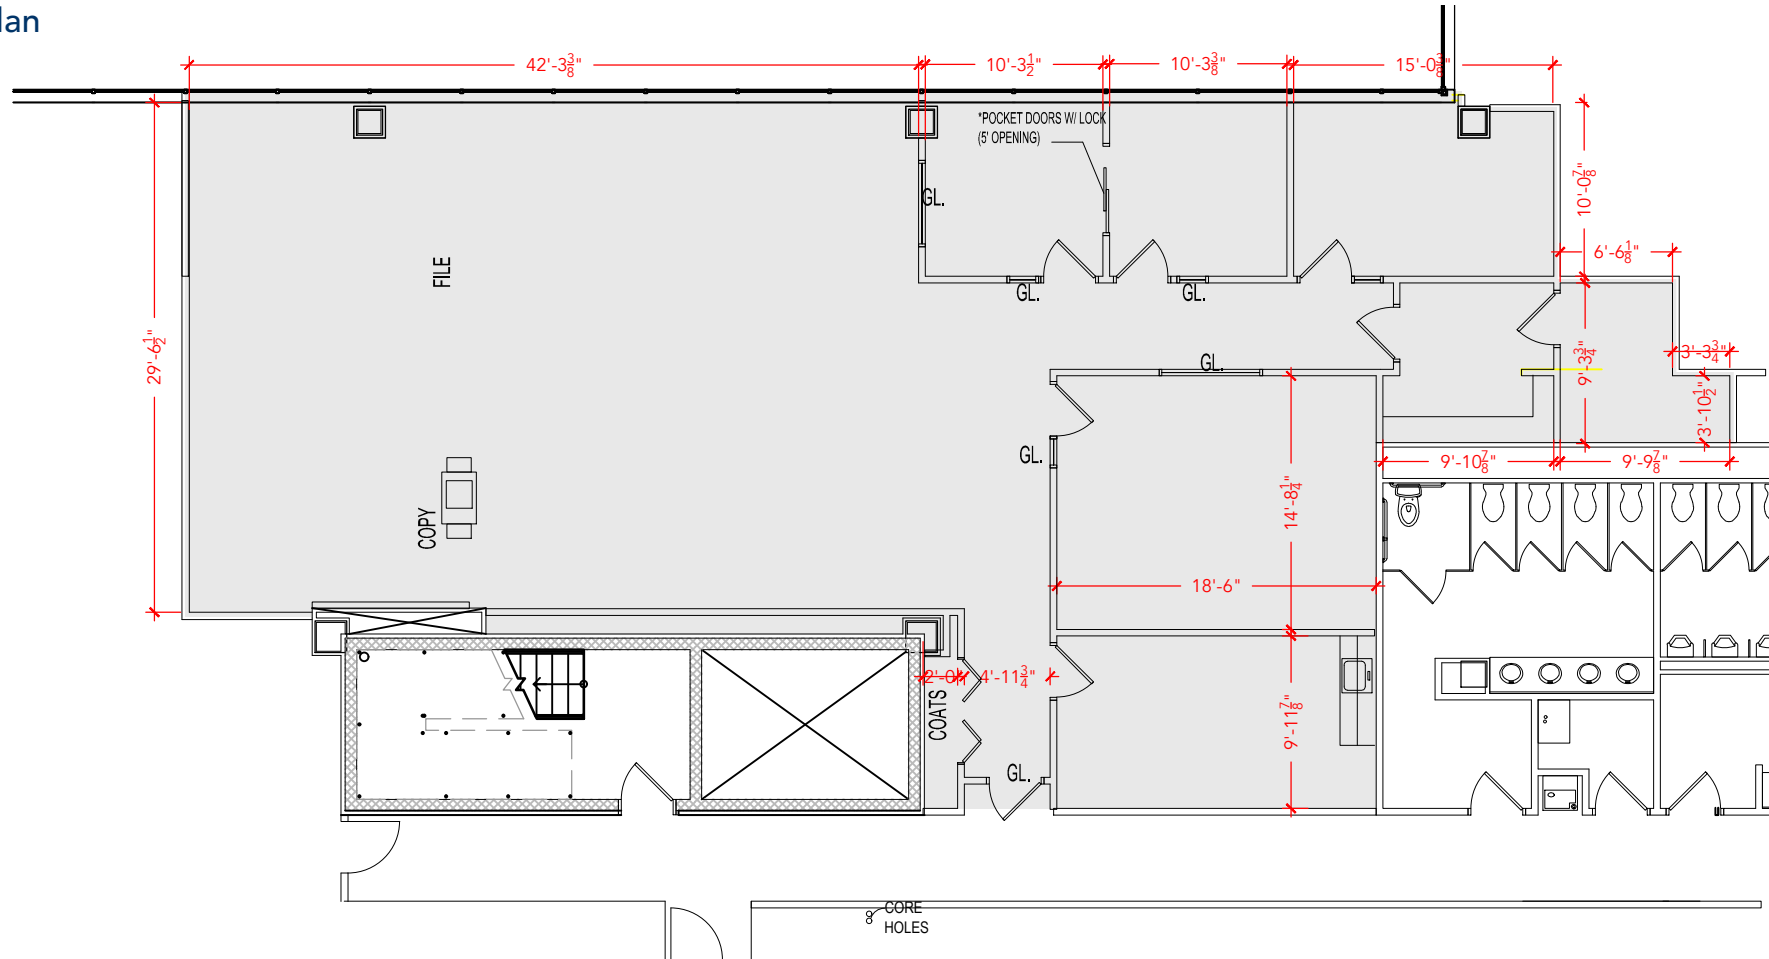

## Floor Plan