



TOTAL SF AVAILABLE -857 RSF(12%)

[Click to access CADD file](#)

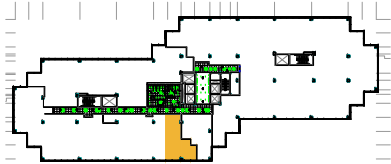

Key Plan

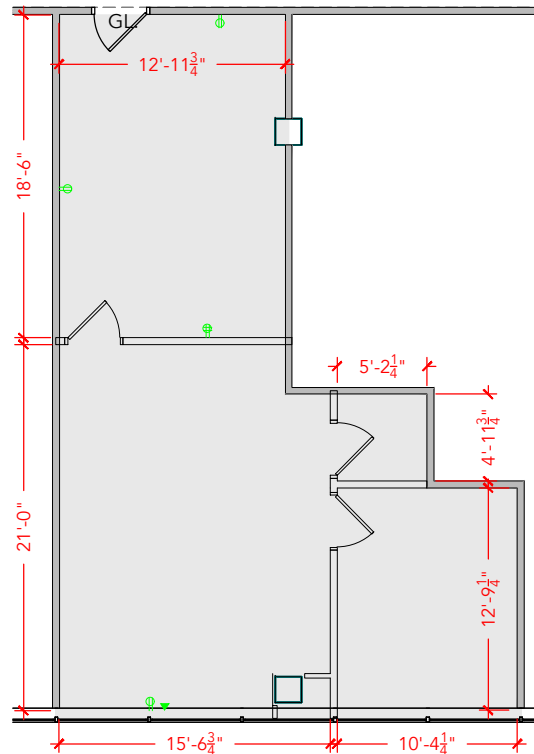

Floor Plan