

LEVEL FIVE




**TOTAL SF AVAILABLE -2,107 RSF**

OFFICE - 0,000 SF  
WAREHOUSE SF - 2,107 RSF

[Click to access 3D model](#)

Key Plan

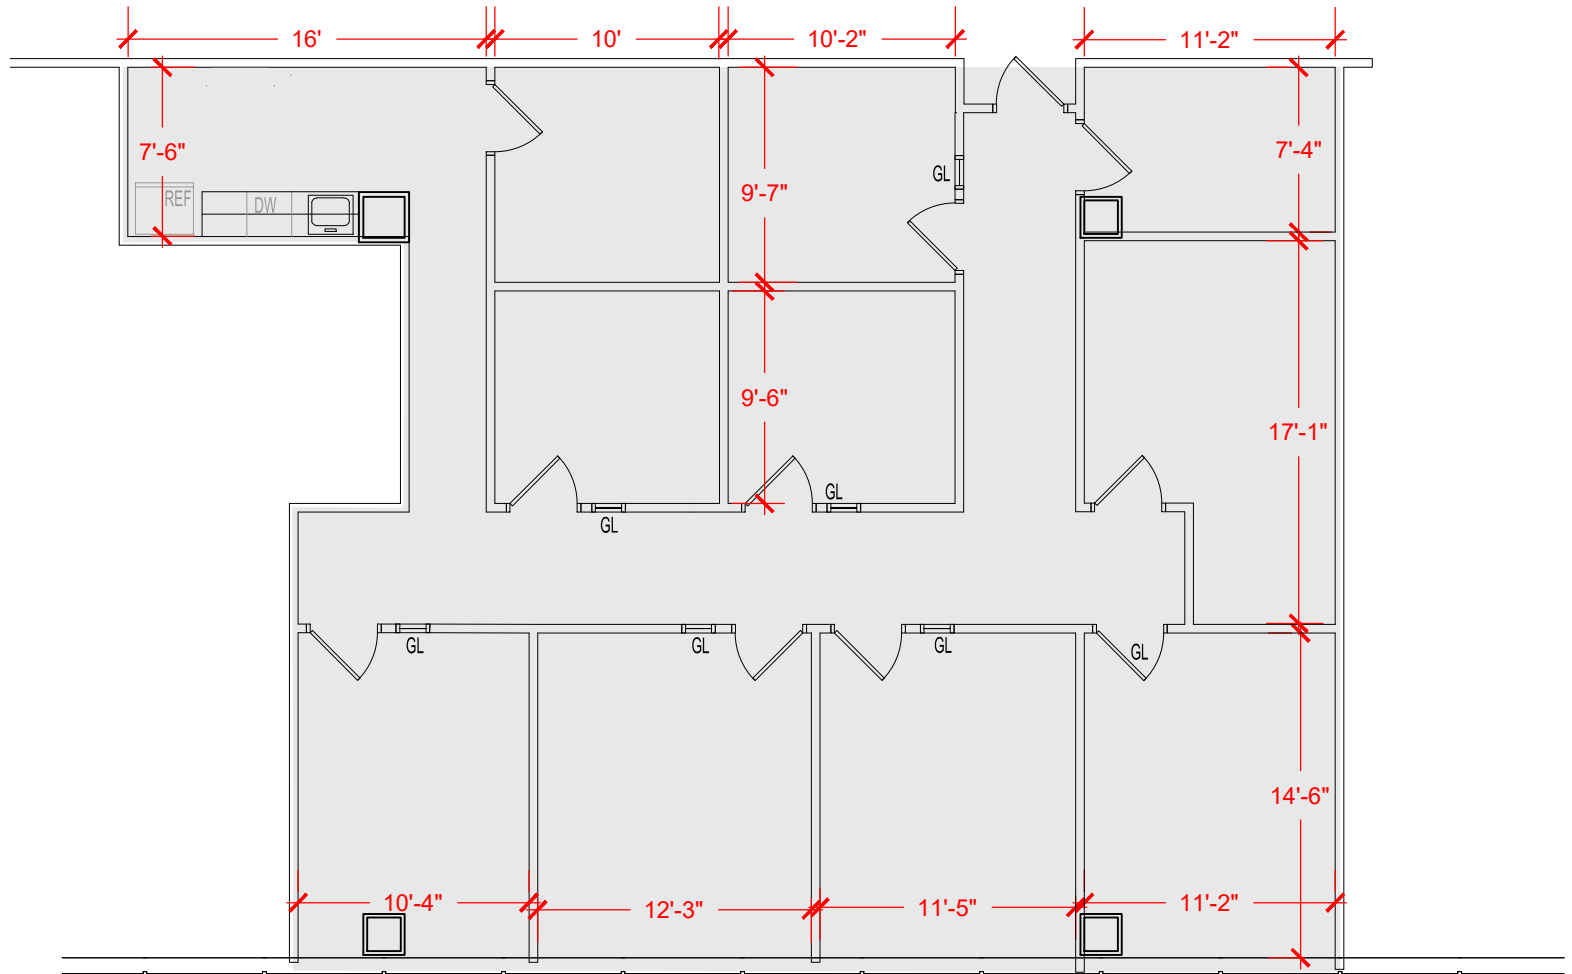

Floor Plan