



TOTAL SF AVAILABLE - 4,312 RSF(12%)

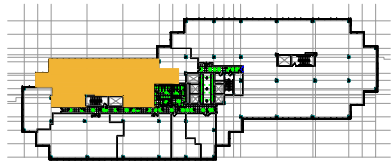

Key Plan

[Click to access CADD file](#)

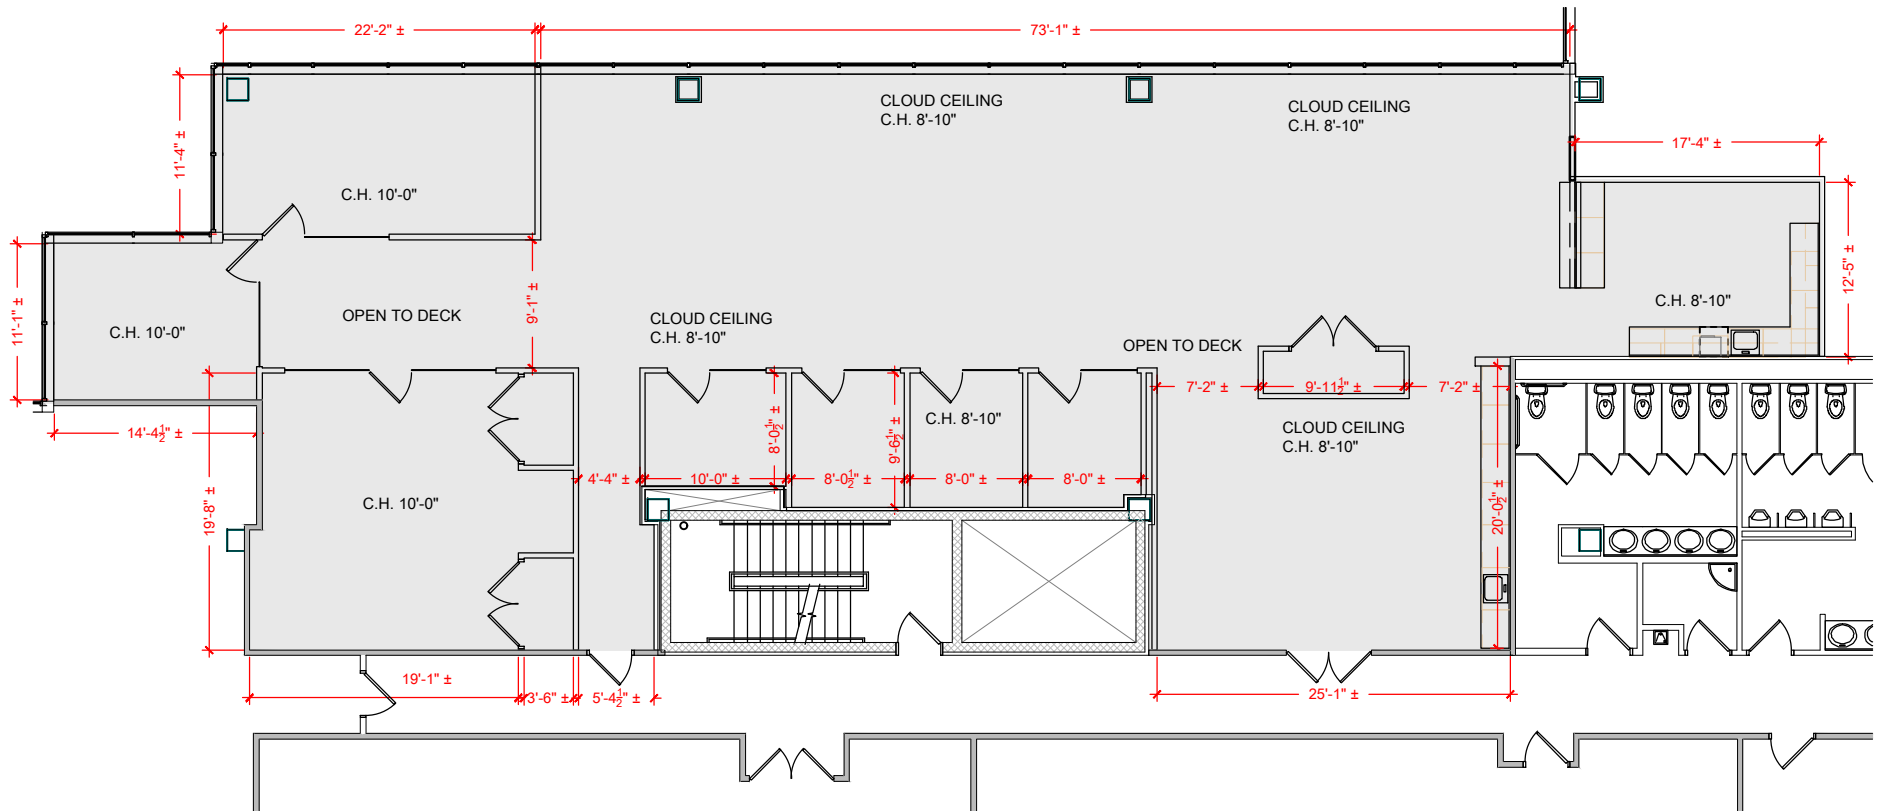

Floor Plan