



TOTAL SF AVAILABLE - 4,238 RSF (12%)

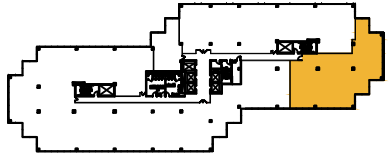

Key Plan

[Click to access 3D model](#)

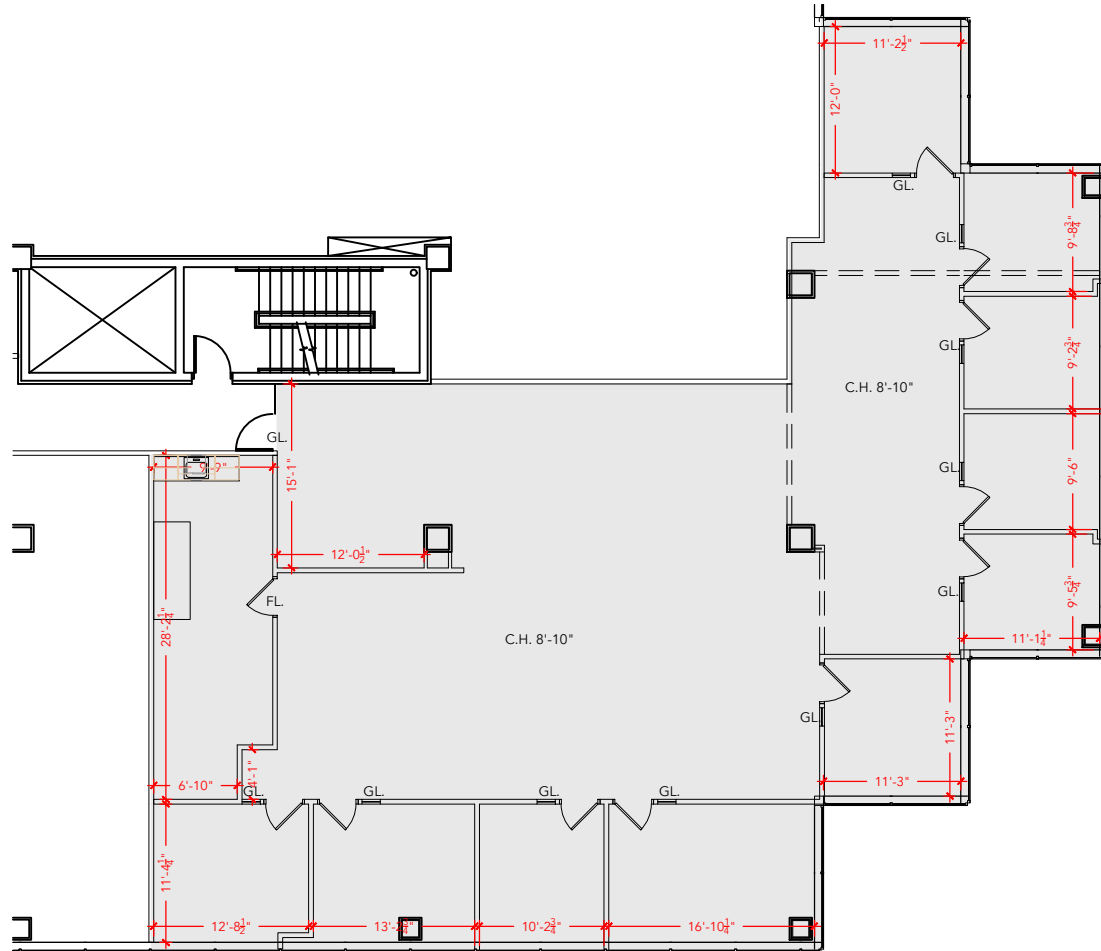

## Floor Plan