
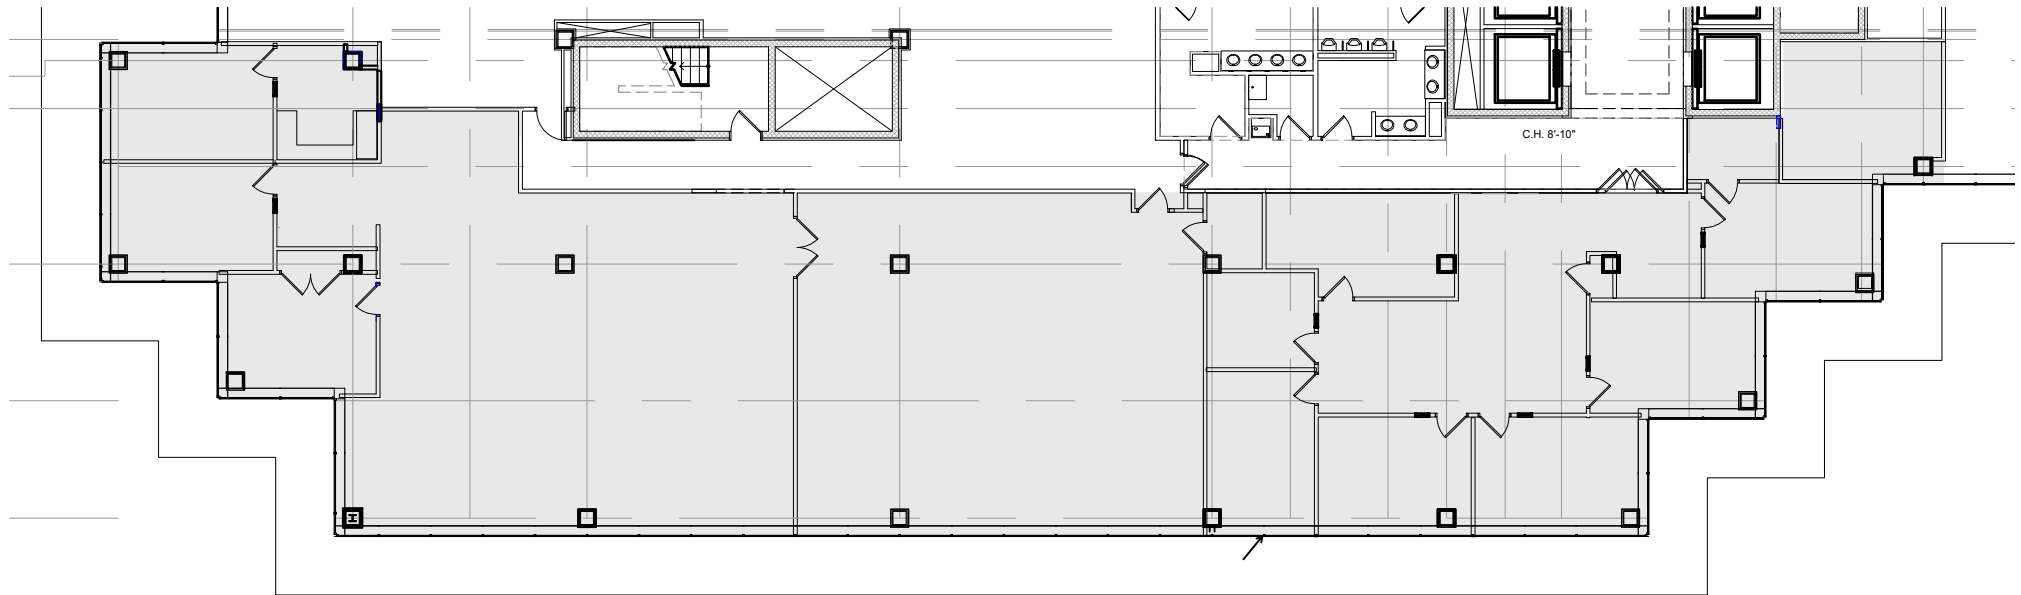


TOTAL SF AVAILABLE - 7,124 RSF(12%)

[Click to access 3D model](#)

Key Plan

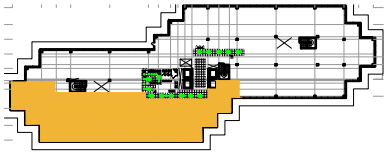

AVAILABLE  
4.25.22 (KD)  
7,124 RSF(12%)

Floor Plan