


Timonium Two

1954 Greenspring Drive
Suites LL20-LL22
Timonium, MD 21093



Building Key Plan

Total SF Office Available
3,955 SF

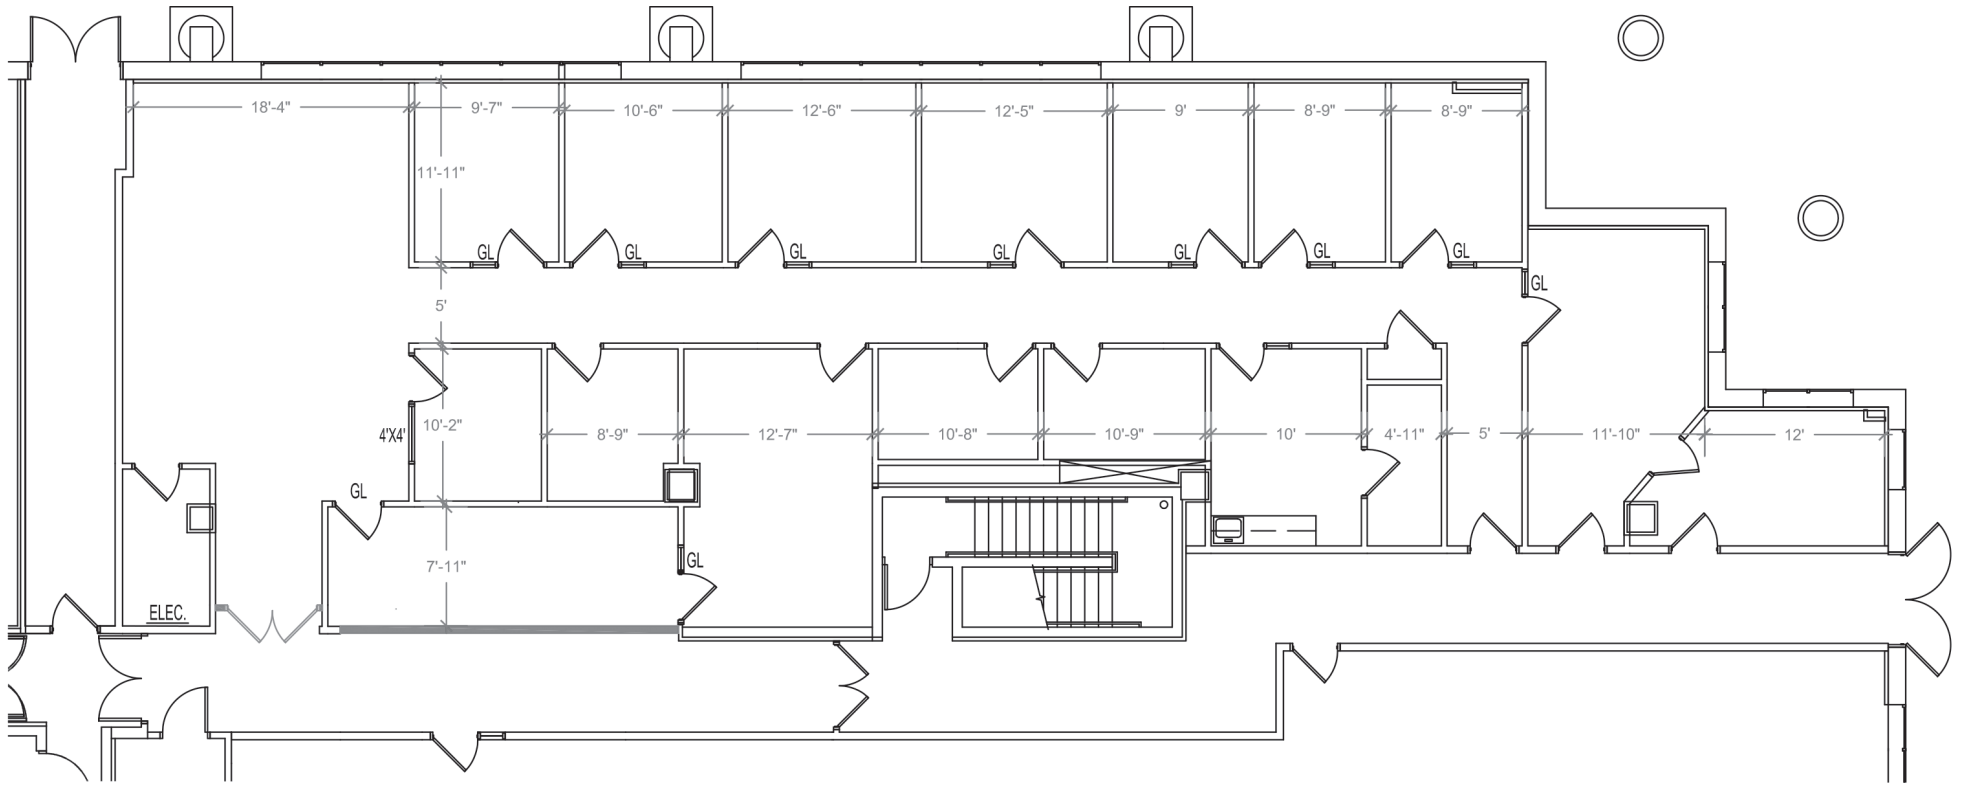

Plan not to scale - this is not a construction document.