


TIMONIUM TWO


1954 GREENSPRING DRIVE TIMONIUM, MD 21093
SUITE LL22

TOTAL SF AVAILABLE - 3,898 RSF (12%)

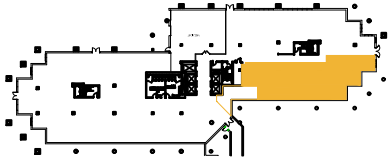

Key Plan

[Click to access 3D model](#)

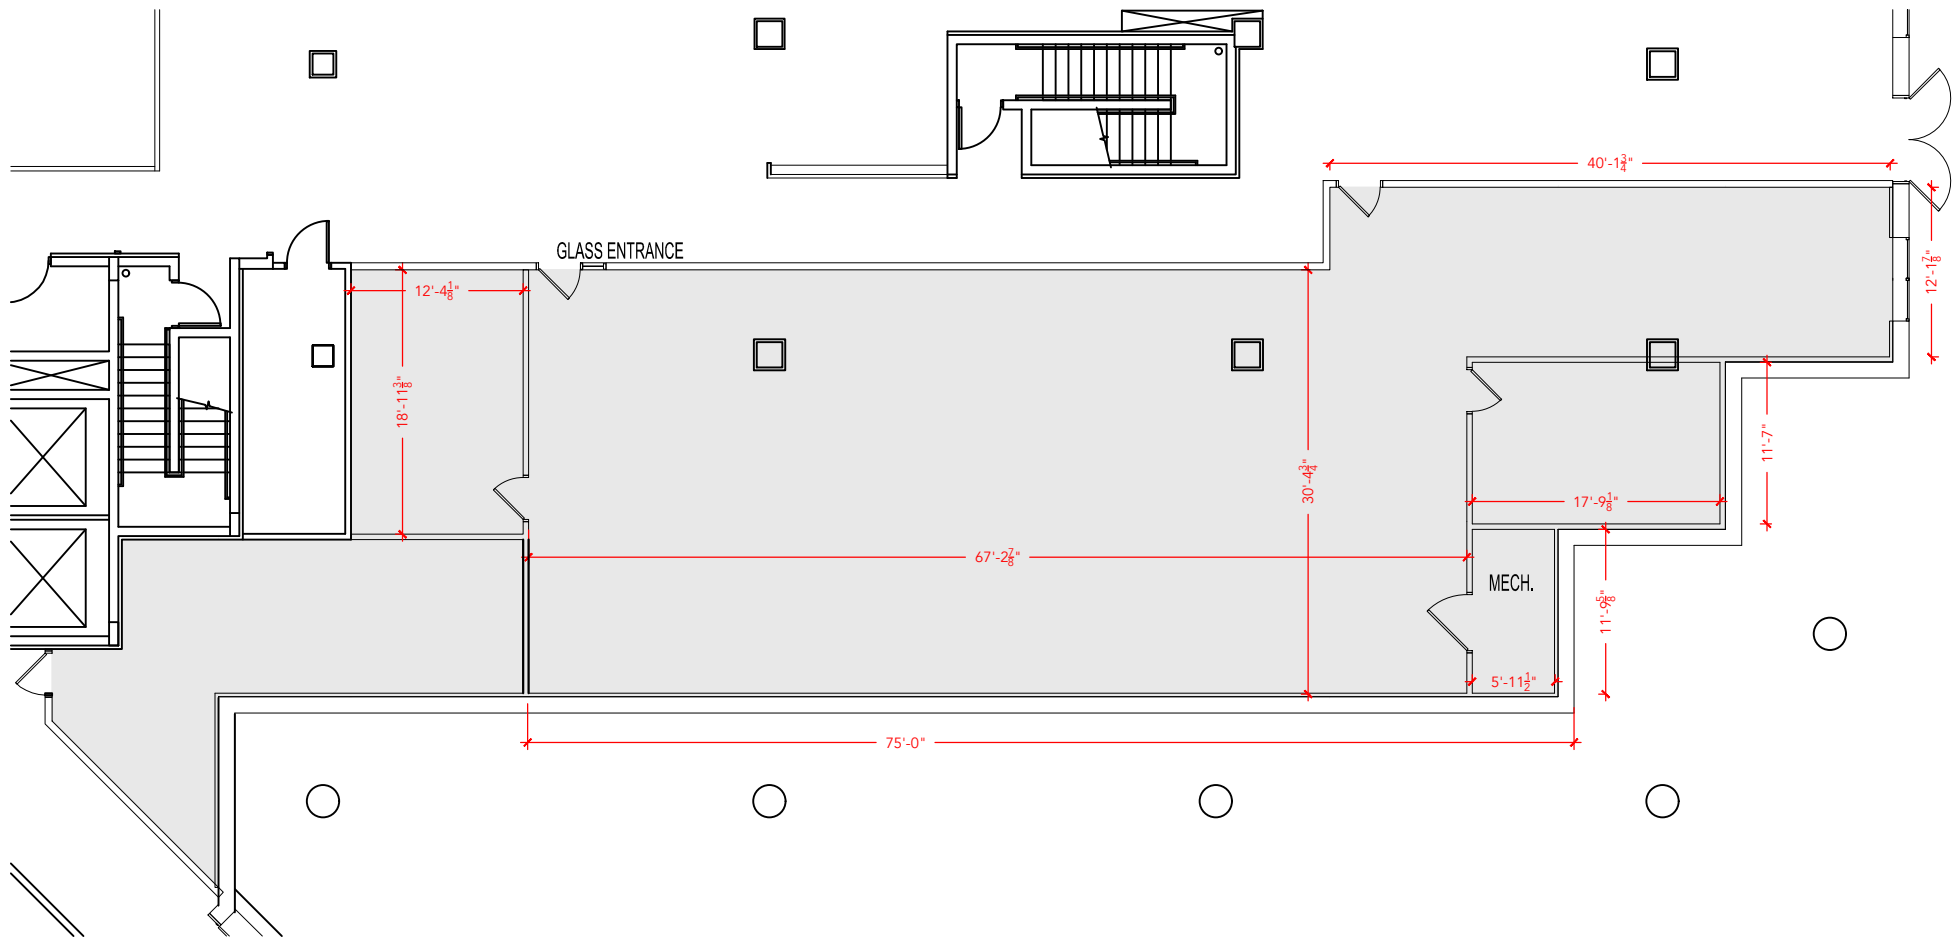

Floor Plan