



TOTAL SF AVAILABLE -3,139 RSF (12%)

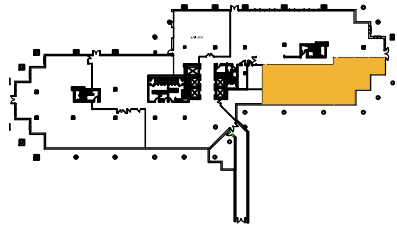

Key Plan

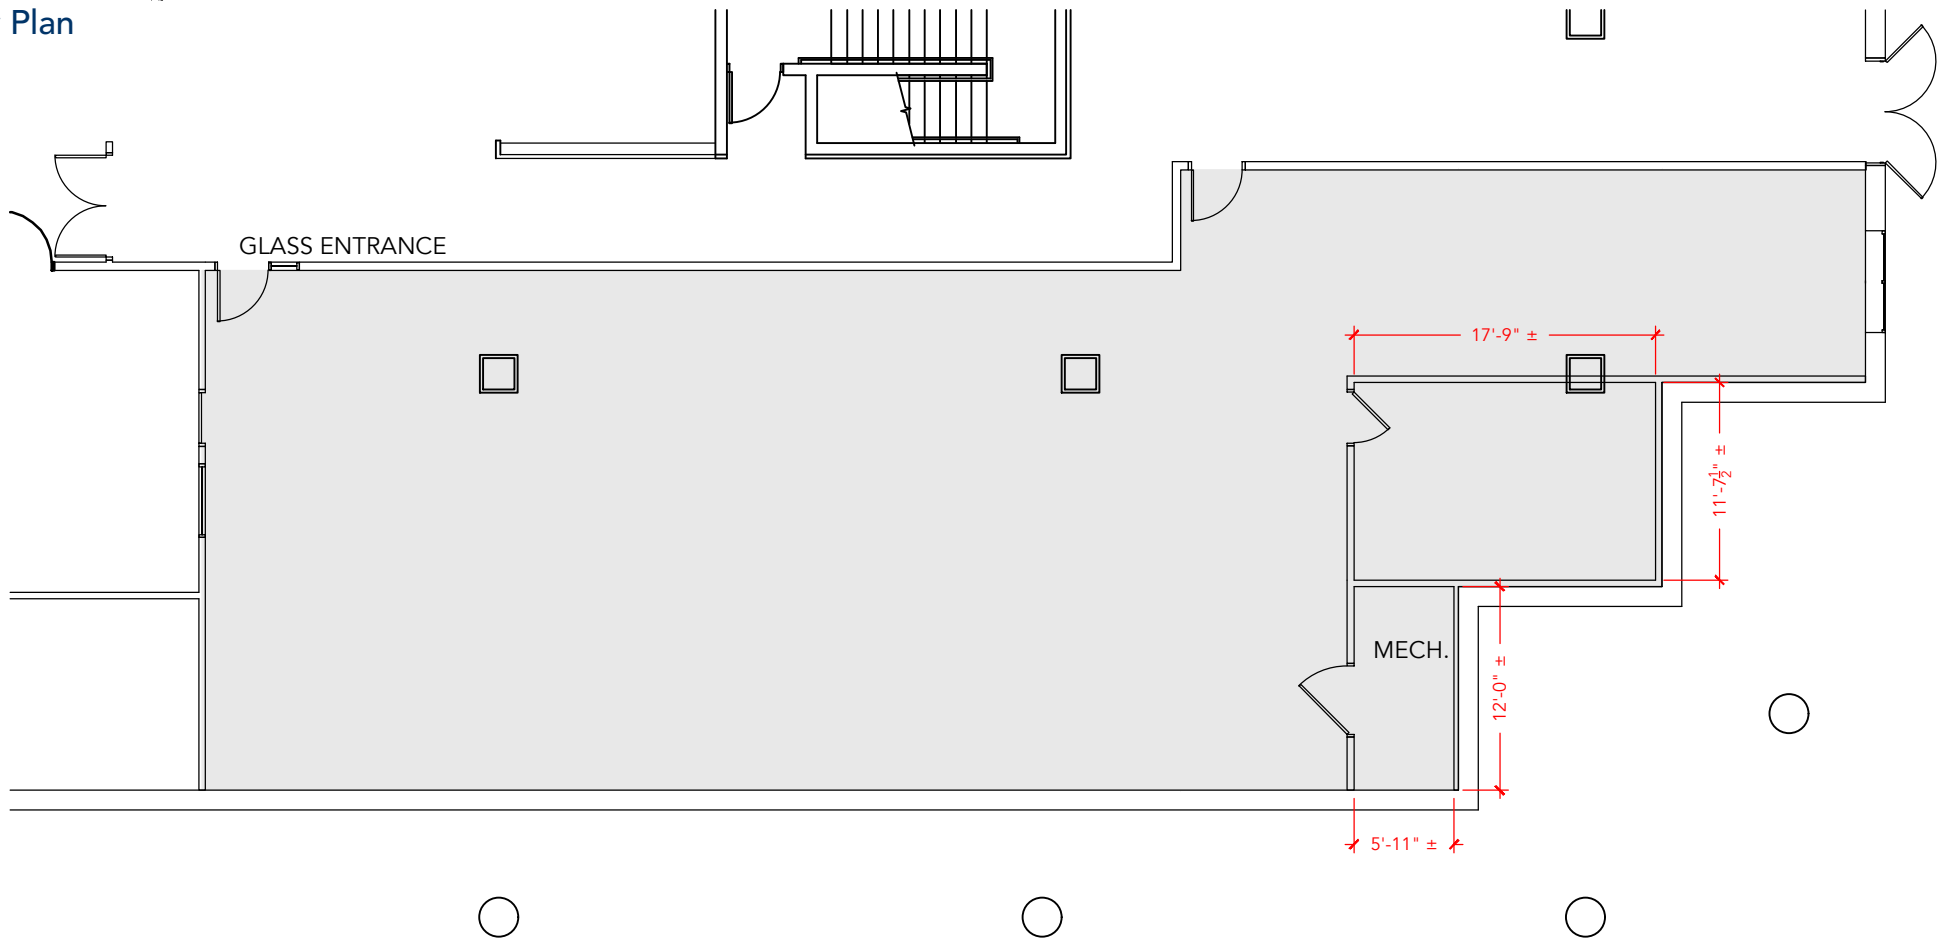

Floor Plan