



TOTAL SF AVAILABLE - 28,086 RSF(12%)

[Click to access 3D model](#)

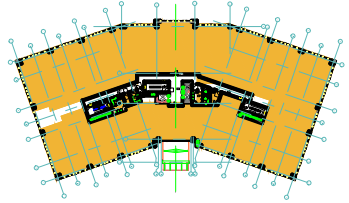

Key Plan

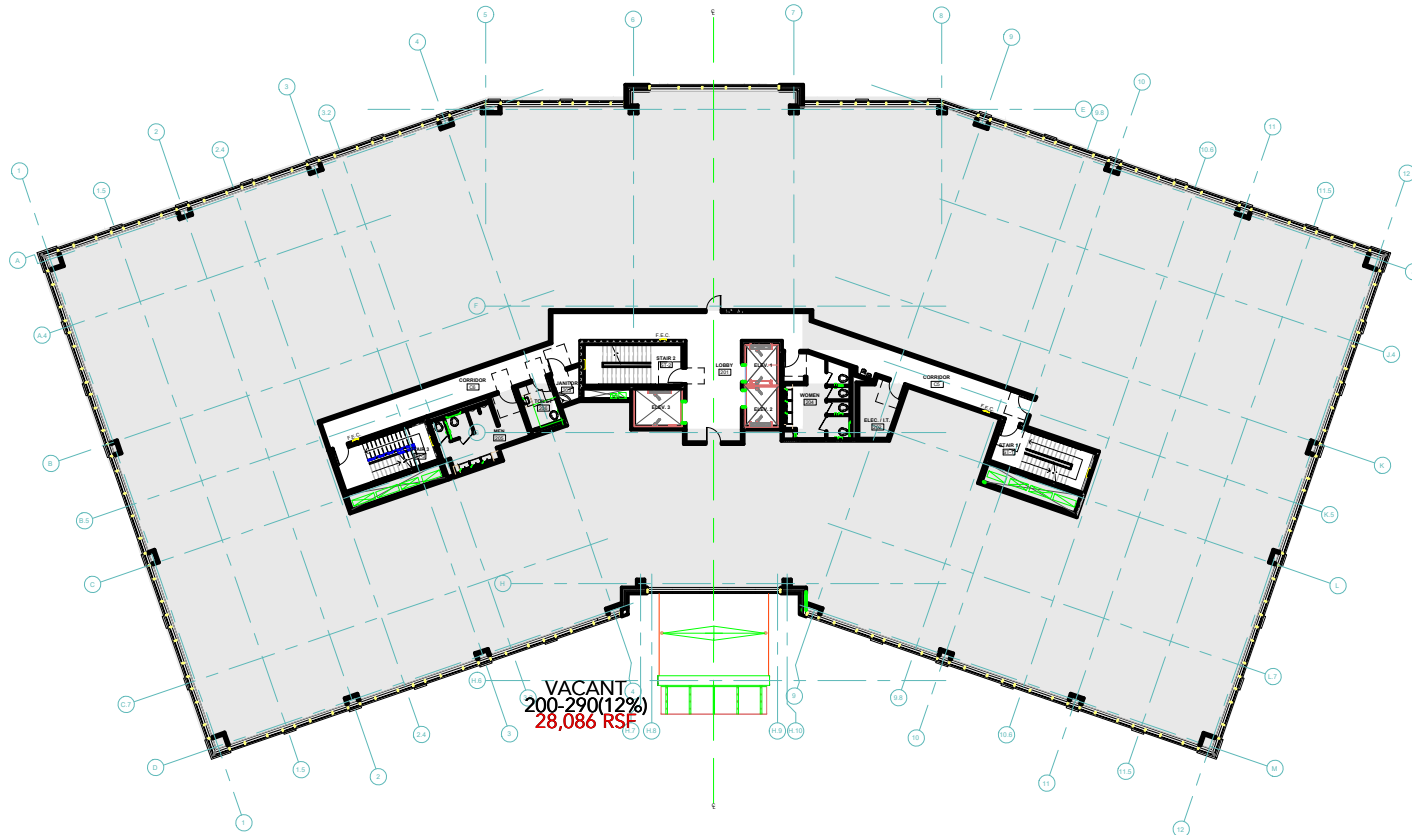

## Floor Plan