


TOTAL SF AVAILABLE - 2,770 RSF

OFFICE - 2,770 RSF


WAREHOUSE - 0,000 SF

* INCLUDES % OF METER ROOM

[Click to access 3D model](#)

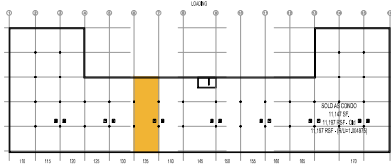

Key Plan

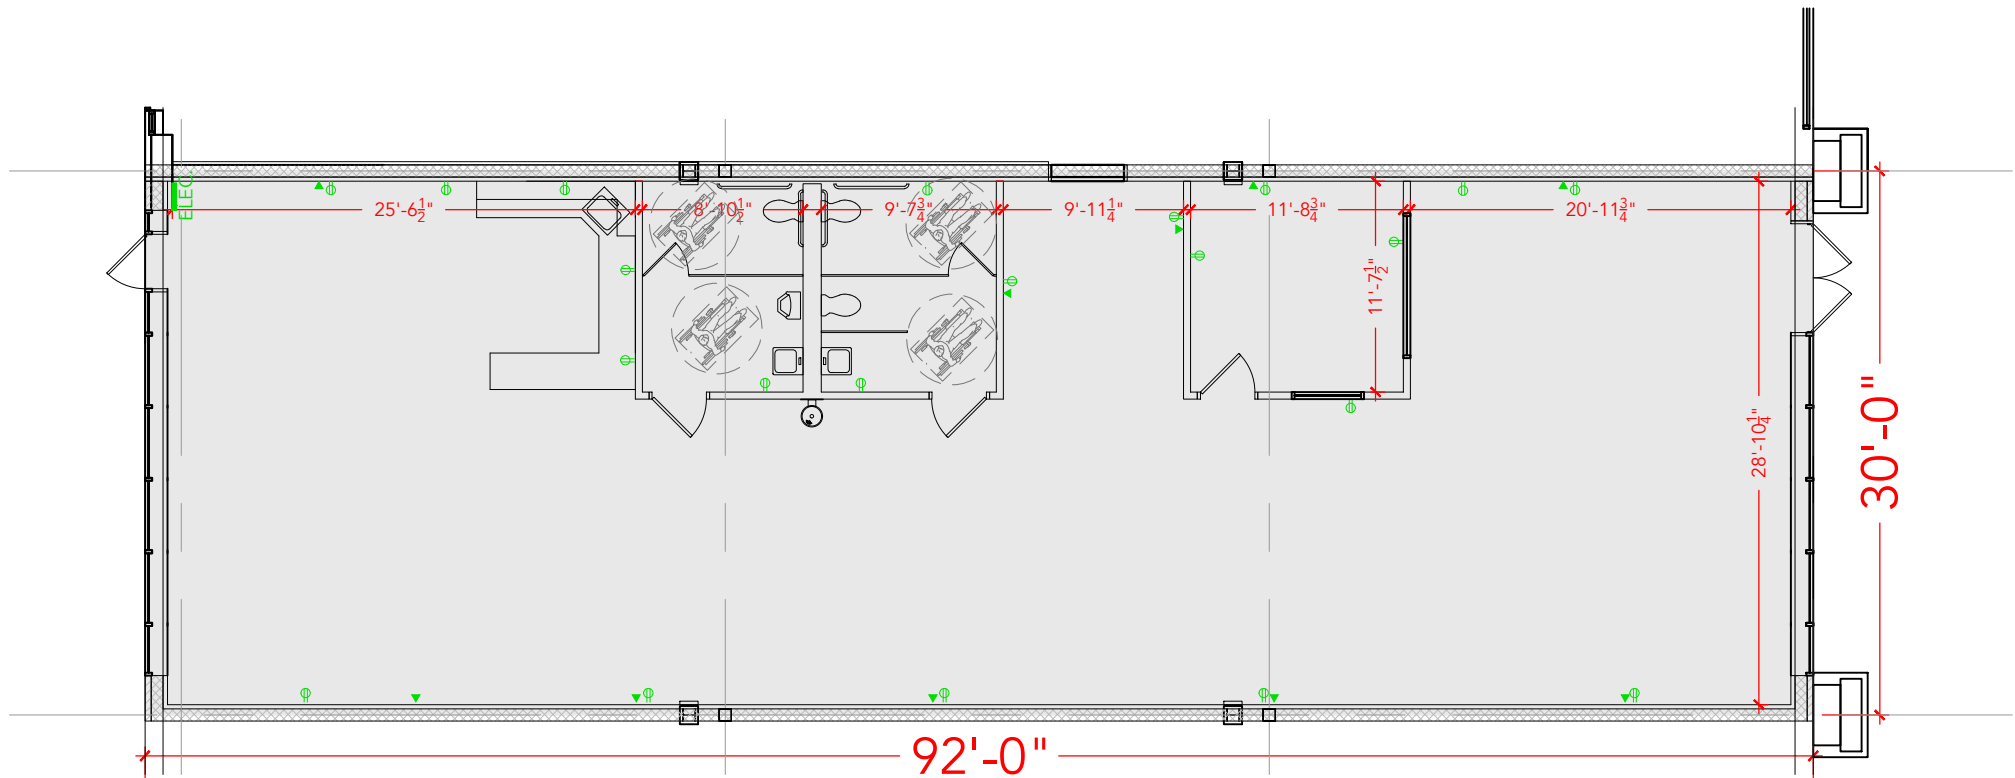

Floor Plan