


TOTAL SF AVAILABLE - 3,466 RSF


OFFICE - 3,466 RSF

WAREHOUSE - 0,000 SF

* INCLUDES % OF METER ROOM
[Click to access 3D model](#)

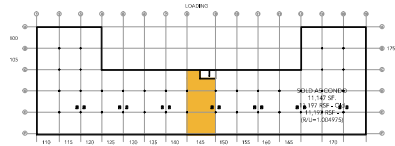

Key Plan

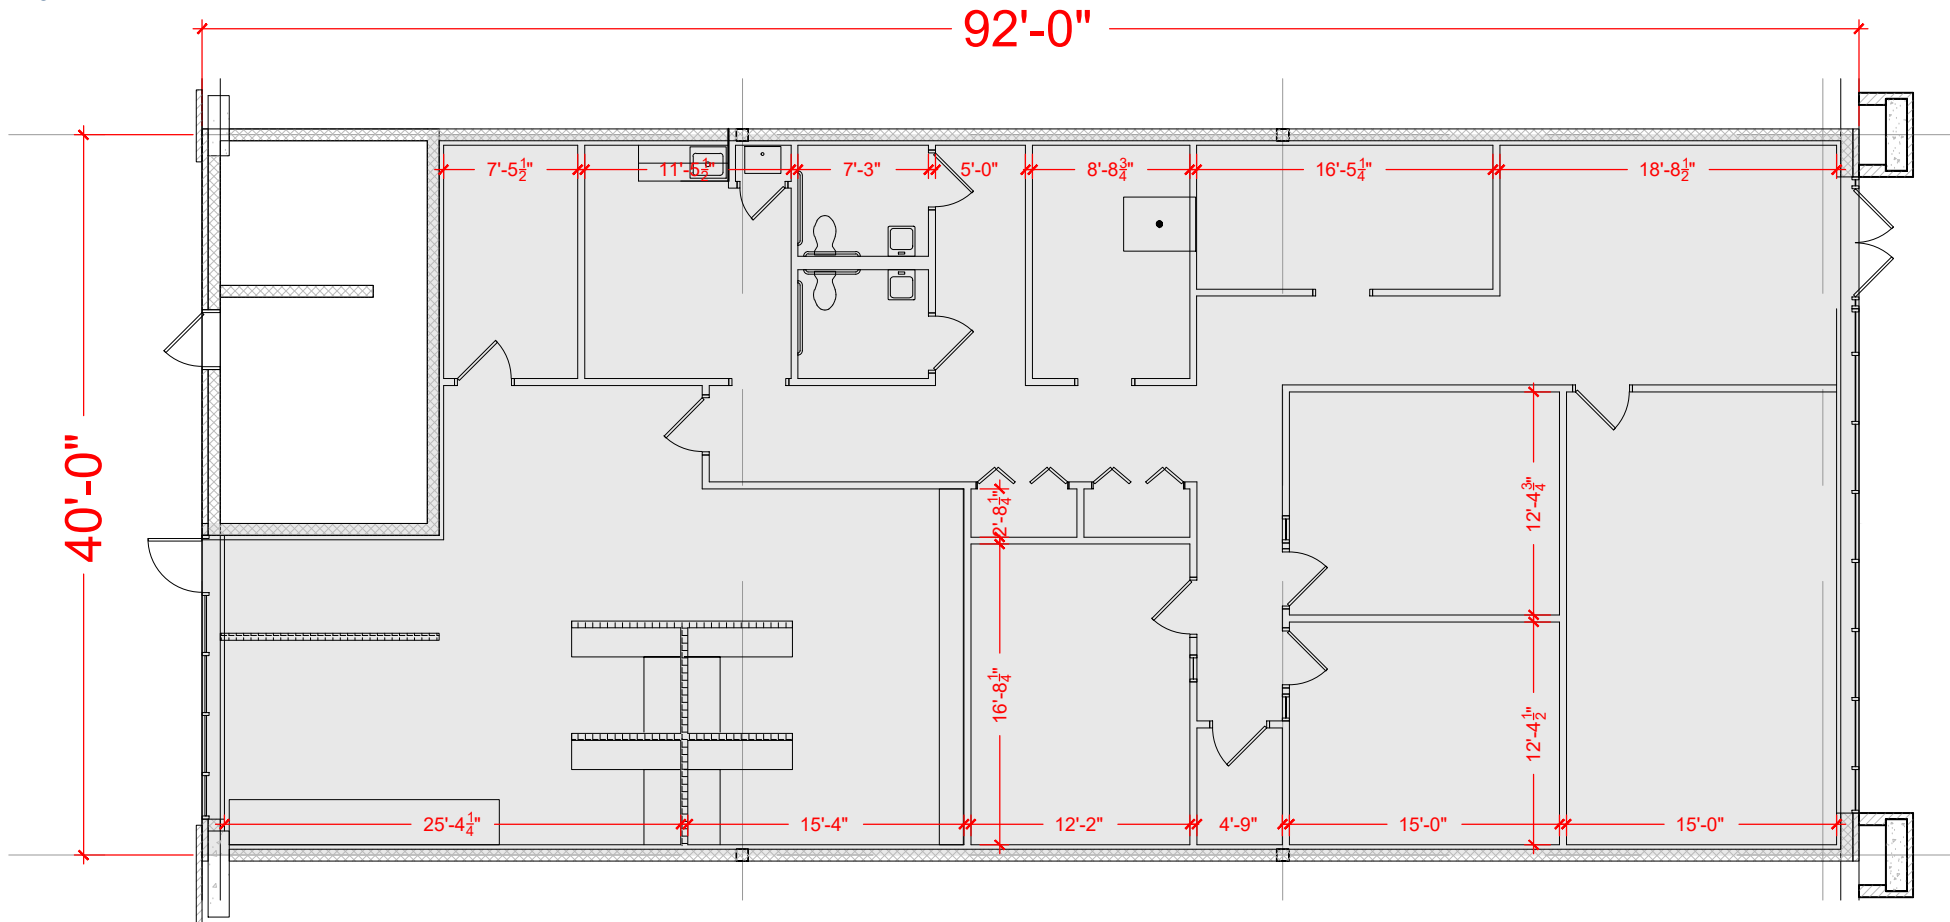

Floor Plan