


**TOTAL SF AVAILABLE - 5,737 RSF**

OFFICE - 5,737 RSF


WAREHOUSE SF - 0,000 SF

INCLUDES % OF METER ROOM

[Click to access 3D model](#)

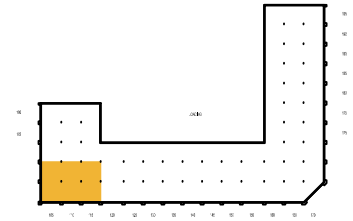

Key Plan

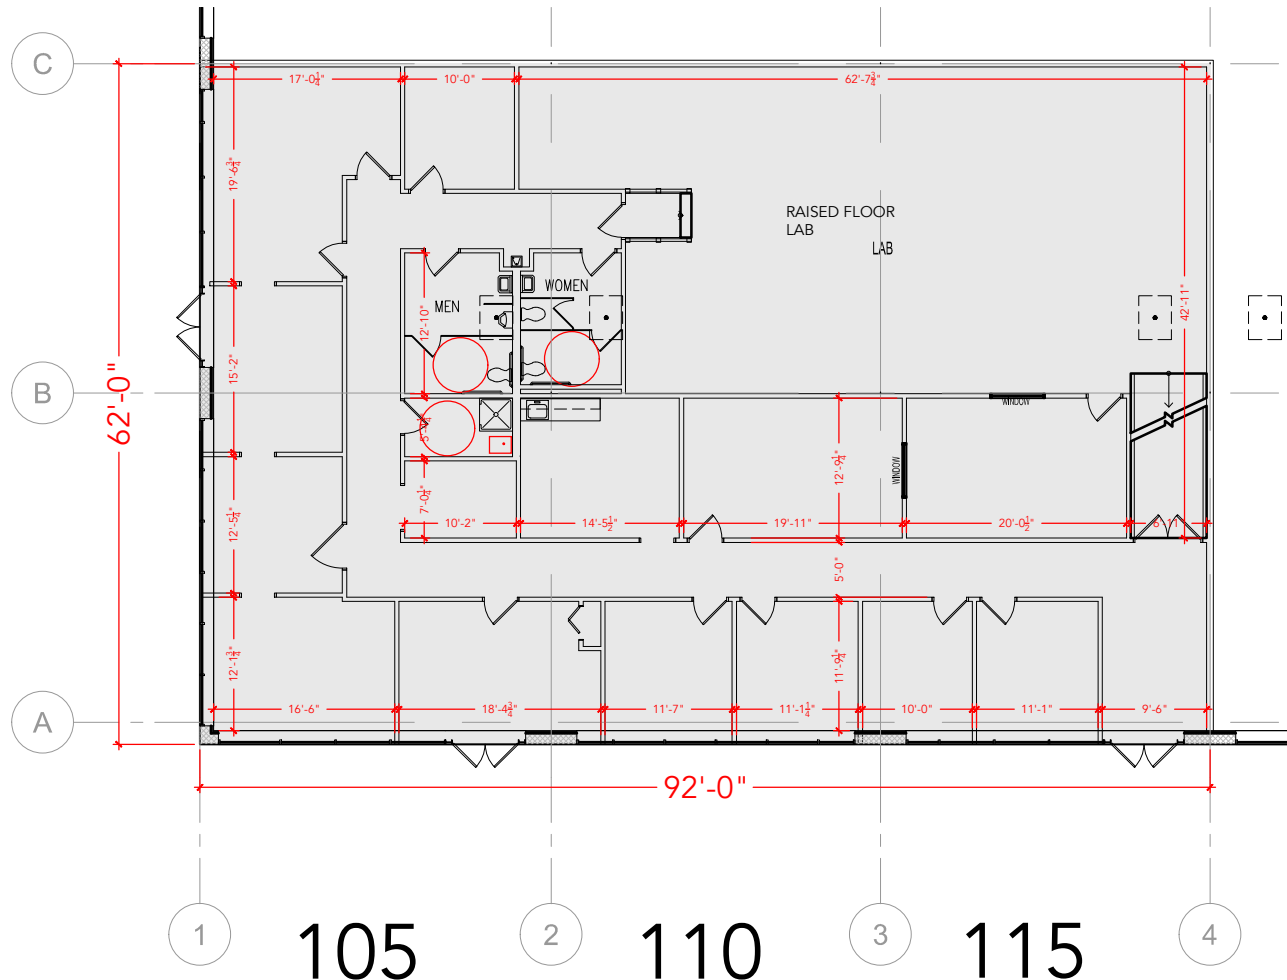

Floor Plan