


TOTAL SF AVAILABLE -3,237 RSF

OFFICE - 3,237 RSF


WAREHOUSE SF - 0,000 SF

*INCLUDES % OF METER ROOM

[Click to access 3D model](#)

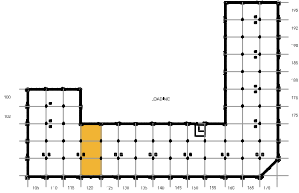

Key Plan

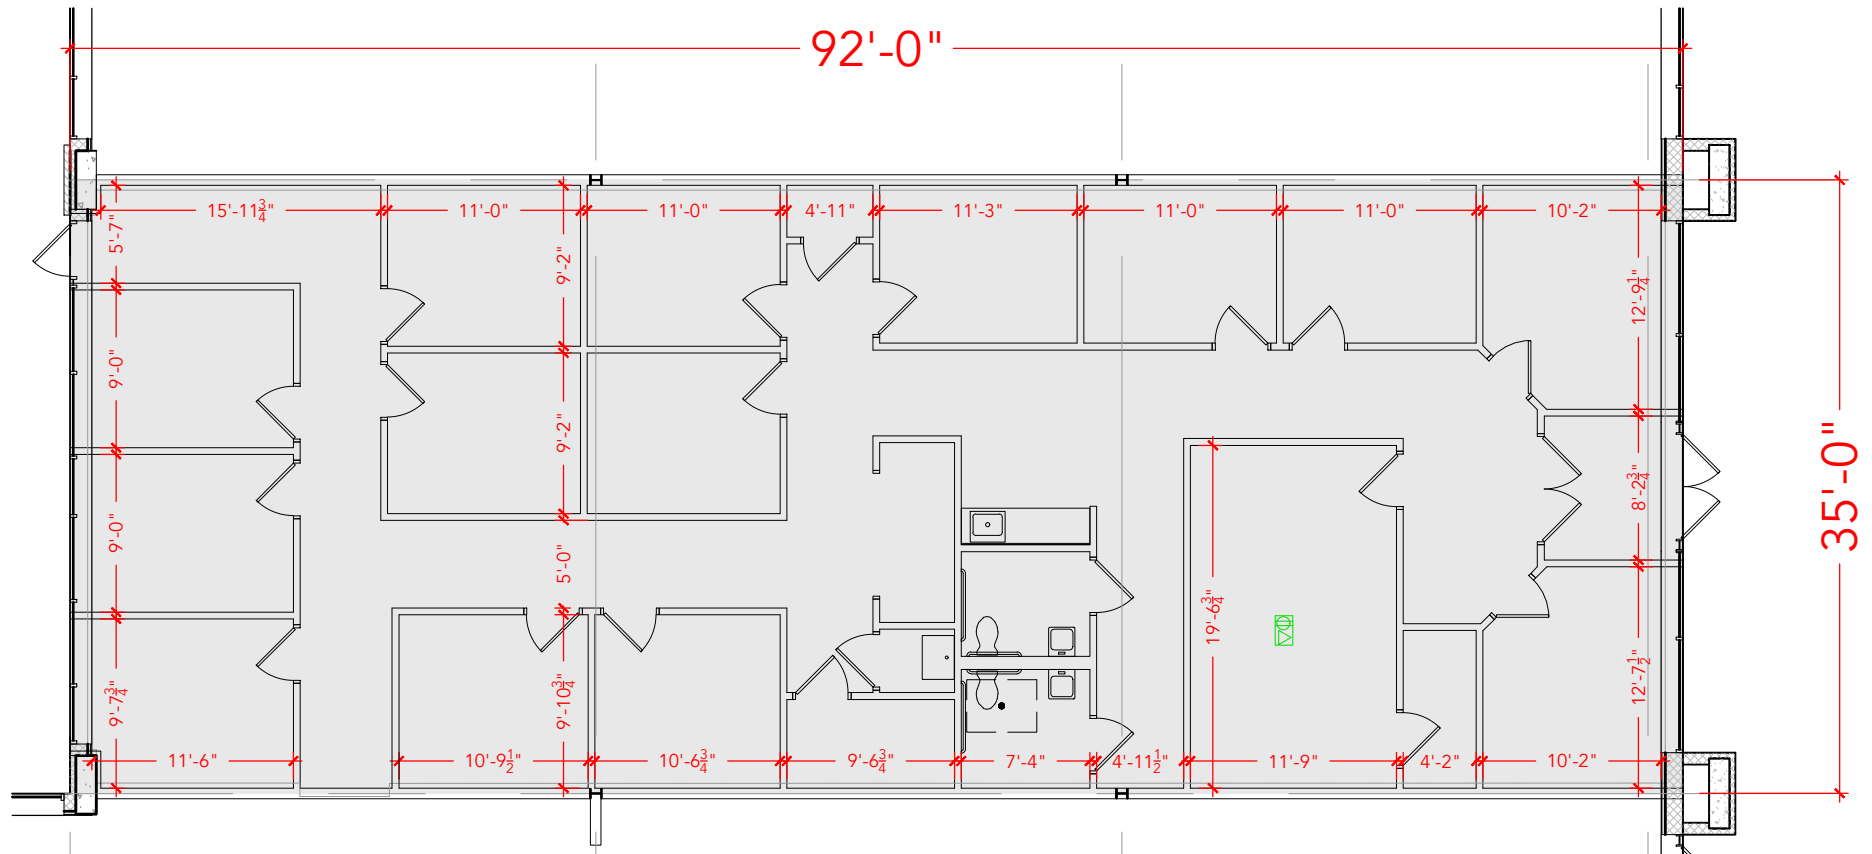

Floor Plan