


Key Plan

TOTAL SF AVAILABLE - 2,774 RSF

OFFICE - 2,774 RSF

WAREHOUSE SF - 0,000 SF

[Click to access 3D model](#)

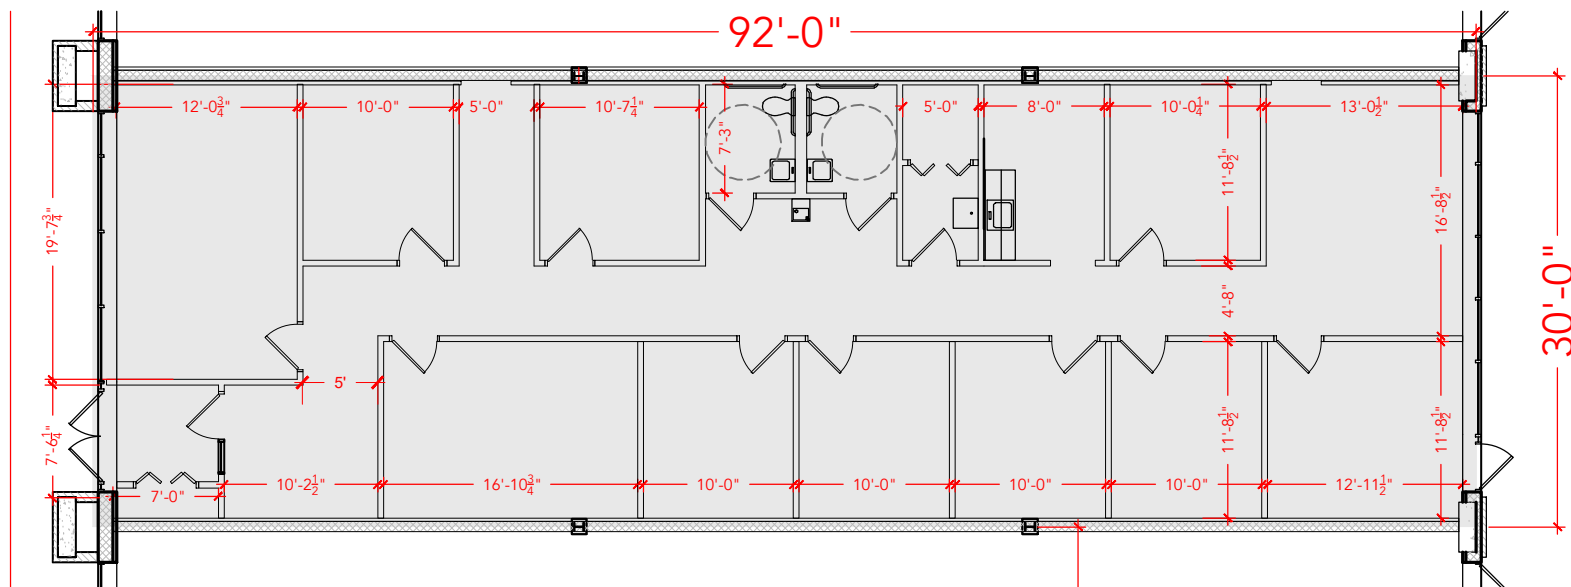

Floor Plan