

Key Plan


TOTAL SF AVAILABLE -16,854 RSF

OFFICE - 16,854 RSF

WAREHOUSE SF - 0,000 SF

INCLUDES % OF METER ROOM

[Click to access 3D model](#)

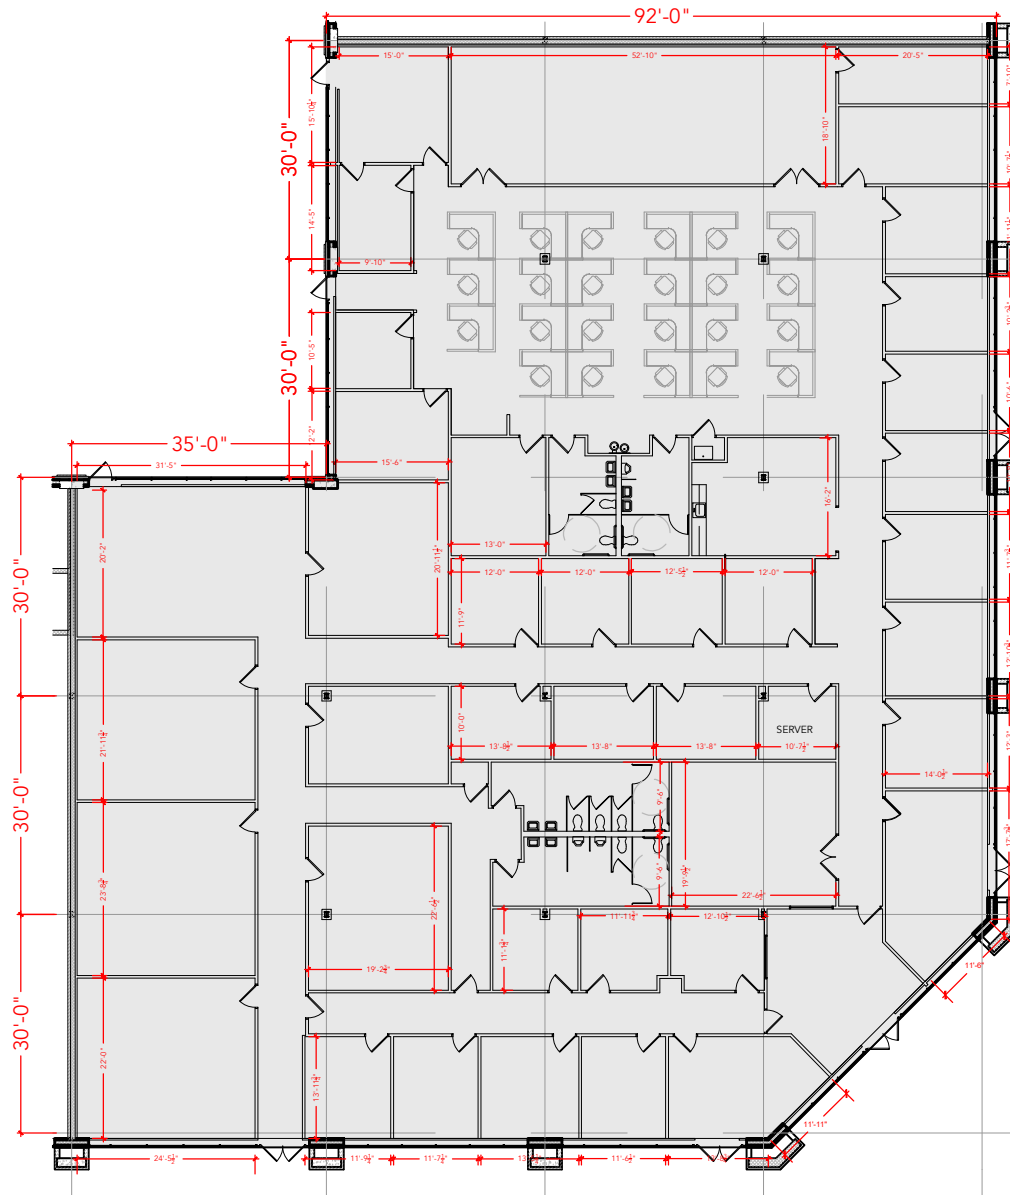

Floor Plan