
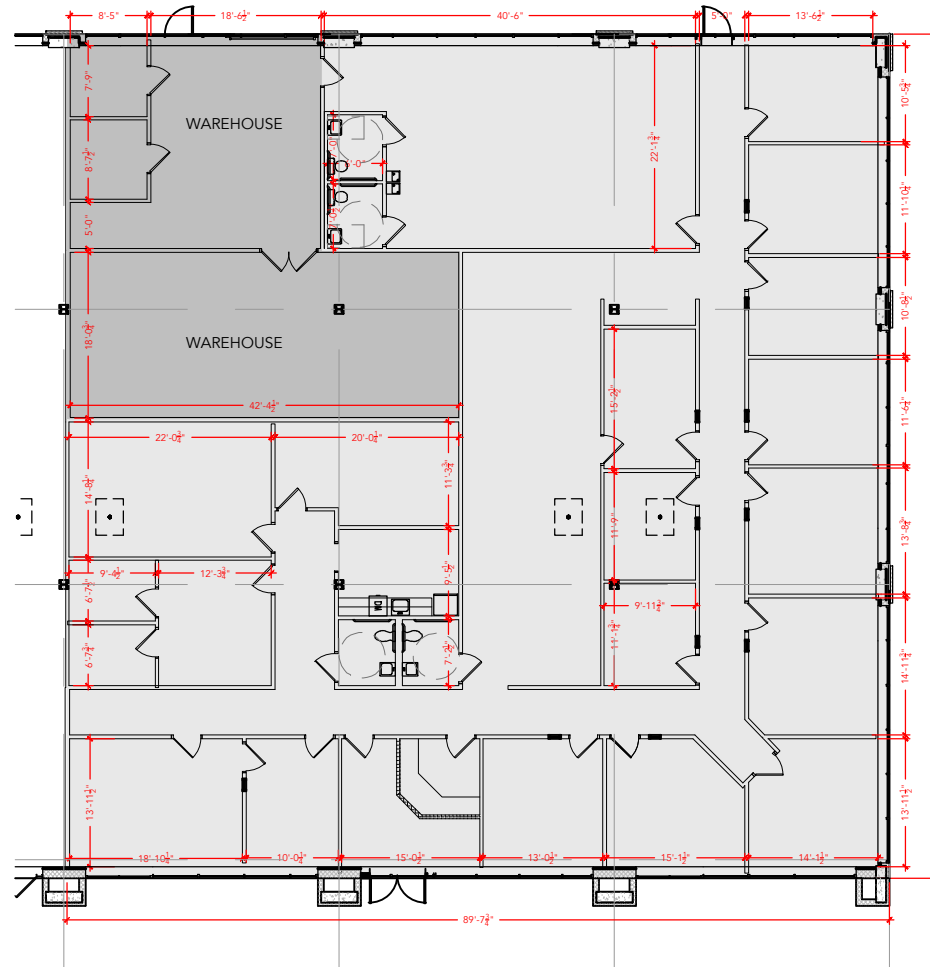


**TOTAL SF AVAILABLE - 8,287 RSF**

OFFICE - 8,287 RSF

WAREHOUSE SF - 0,000 SF

[Click to access 3D model](#)

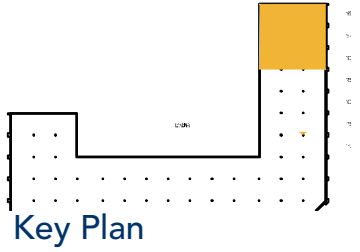

## Floor Plan