


TOTAL SF AVAILABLE - 8,287 RSF

OFFICE - 6,833 RSF


WAREHOUSE SF - 1,454 RSF

* INCLUDES % OF METER ROOM

[Click to access 3D model](#)

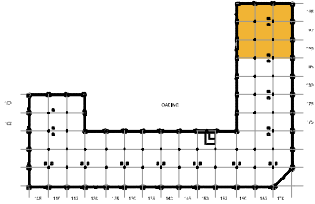

Key Plan

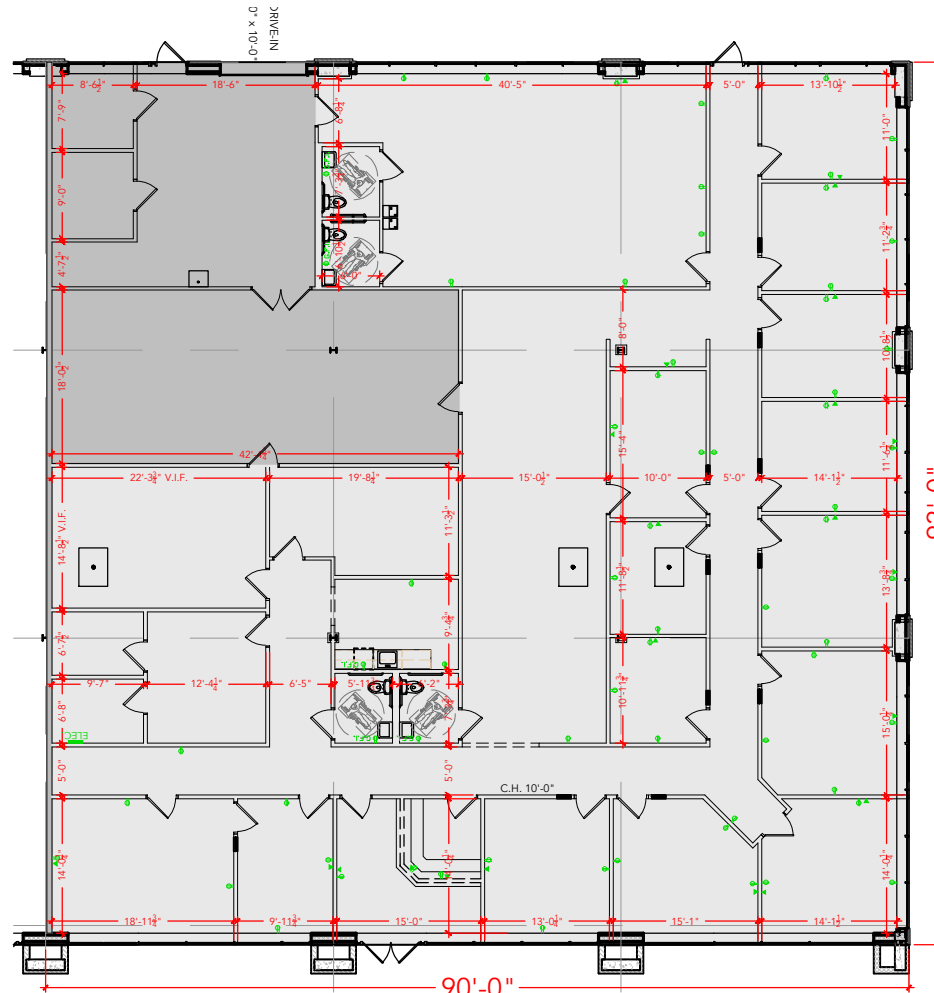

Floor Plan