


Key Plan

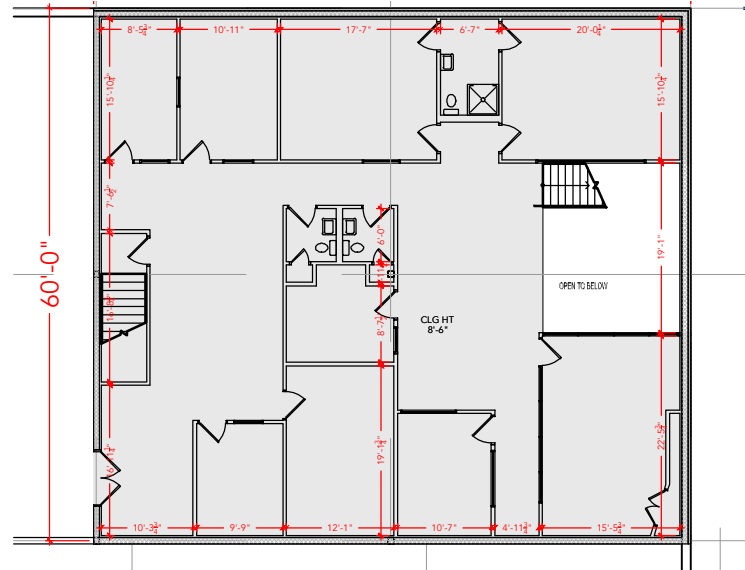


TOTAL SF AVAILABLE - 12,000 SF

OFFICE - 4,013 SF

WAREHOUSE SF - 7,987 SF

* 3,716 SQFT MEZZ NOT INCLUDED IN TOTAL

[Click to access 3D model](#)

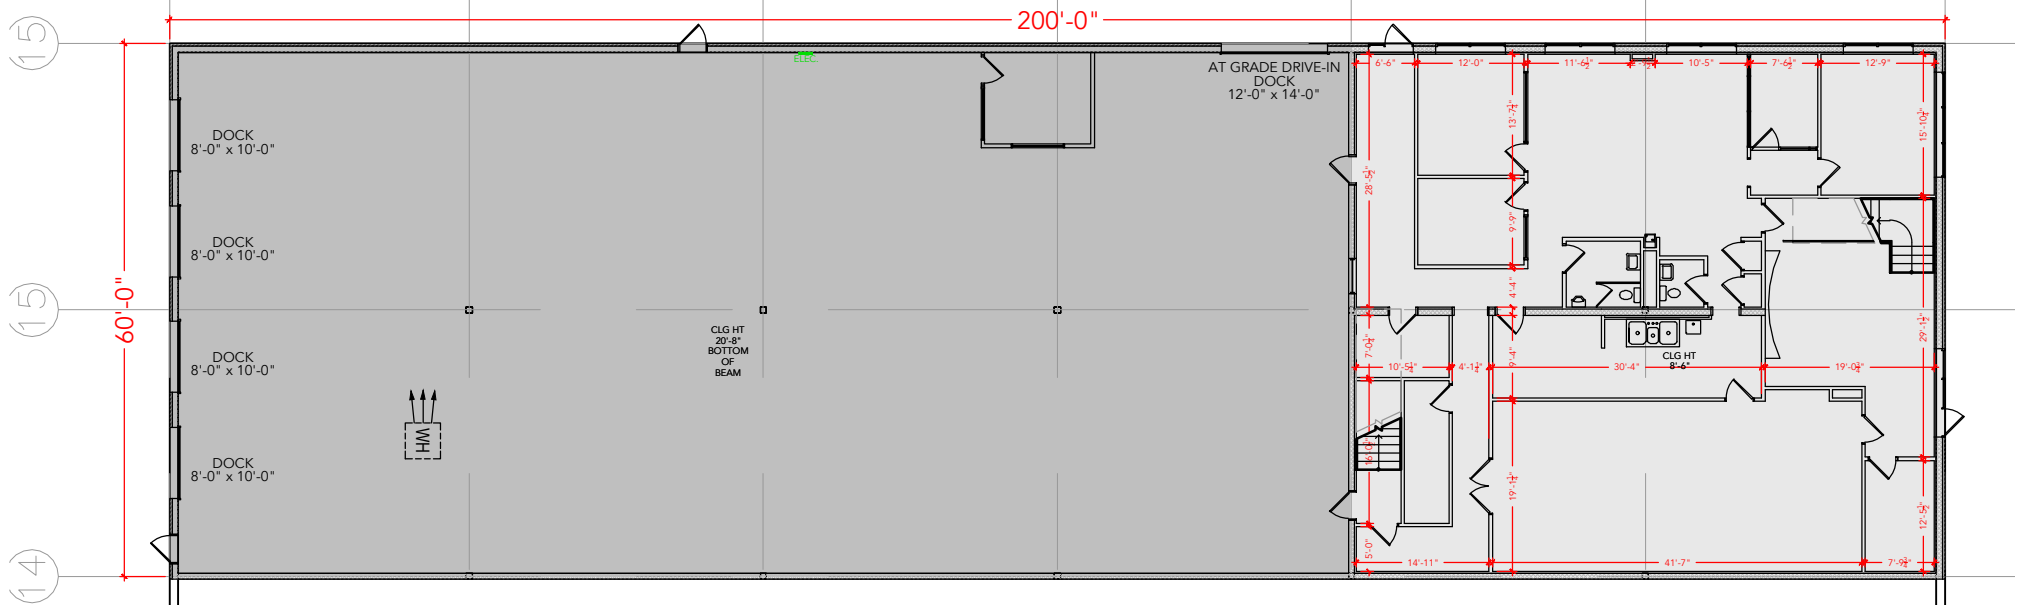

Floor Plan