


**TOTAL SF AVAILABLE - 4,703 SF**


**OFFICE - 607 SF**

**WAREHOUSE - 4,096 SF**

[Click to access 3D model](#)

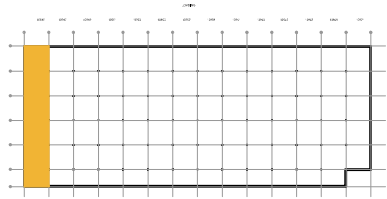

Key Plan

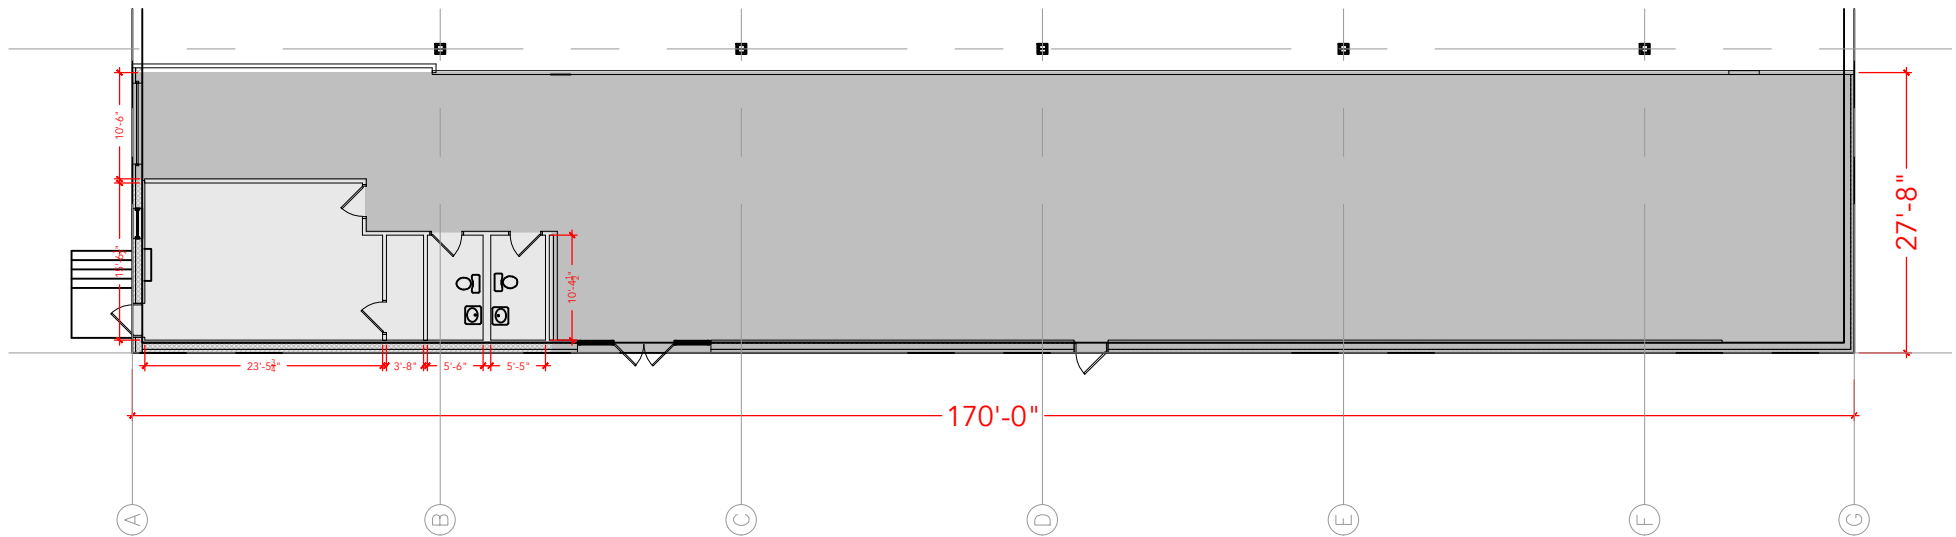

## Floor Plan