


TOTAL SF AVAILABLE -65,940 SF

OFFICE - 12,746 SF


WAREHOUSE - 53,194 SF

[Click to access CADD file](#)

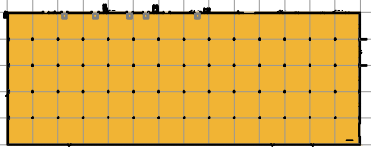

Key Plan

LOADING

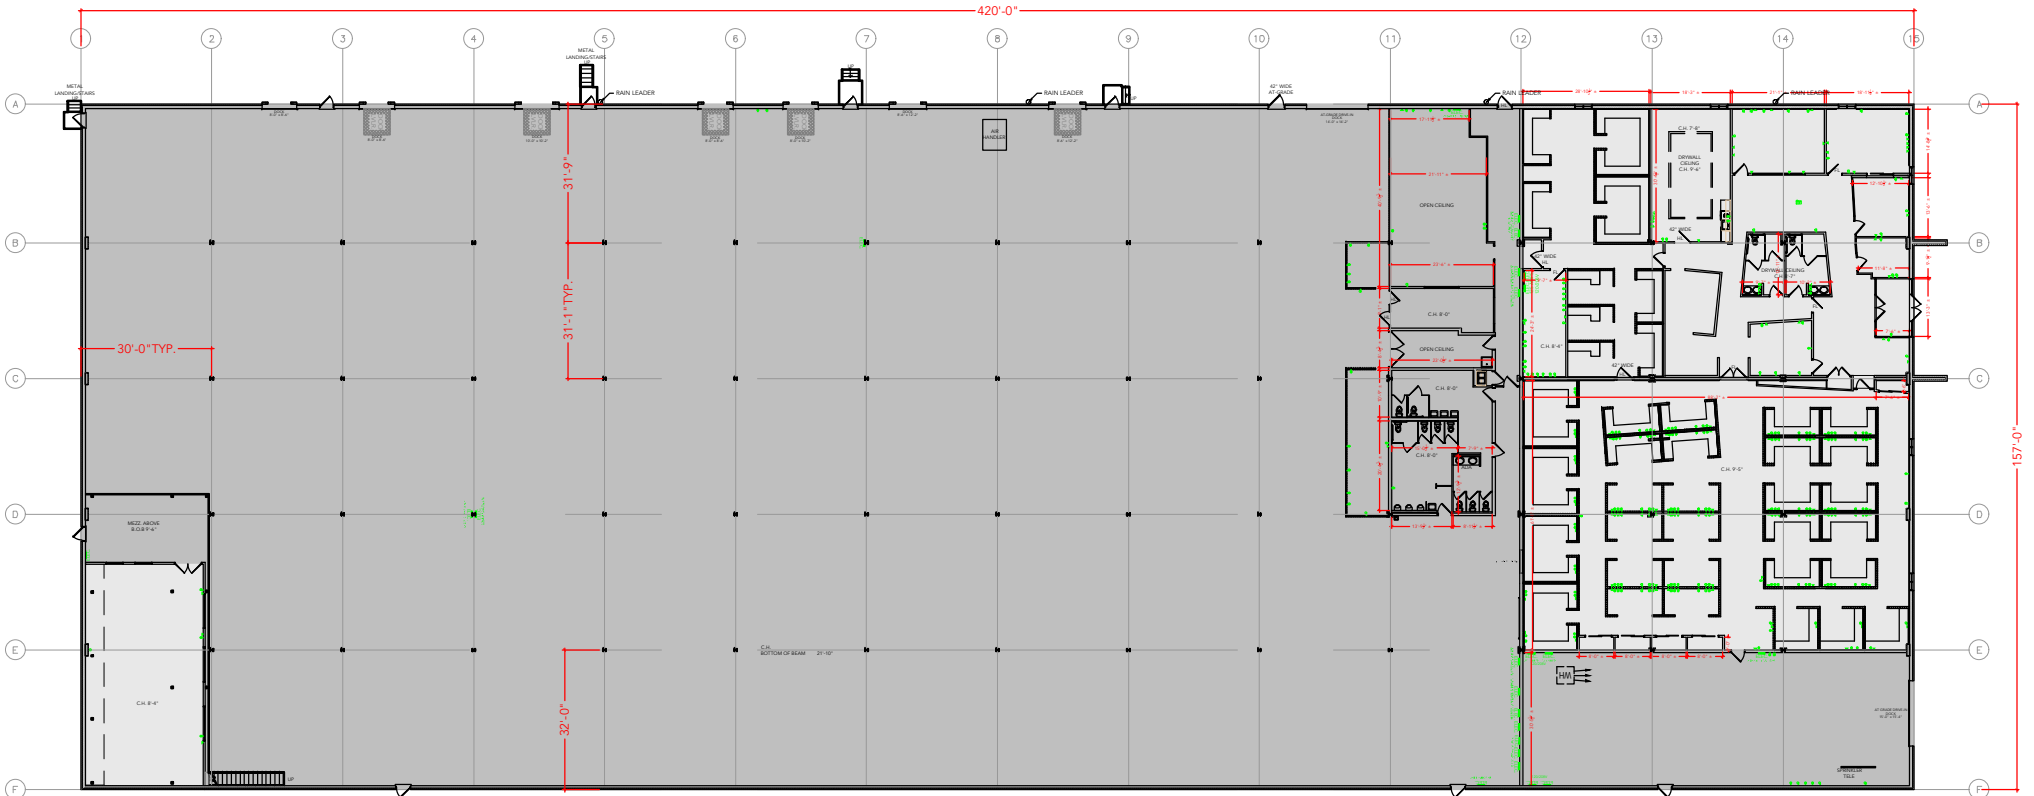

Floor Plan