


TOTAL SF AVAILABLE - 29,871 RSF
* INCLUDED % OF MECH. ROOM



Key Plan

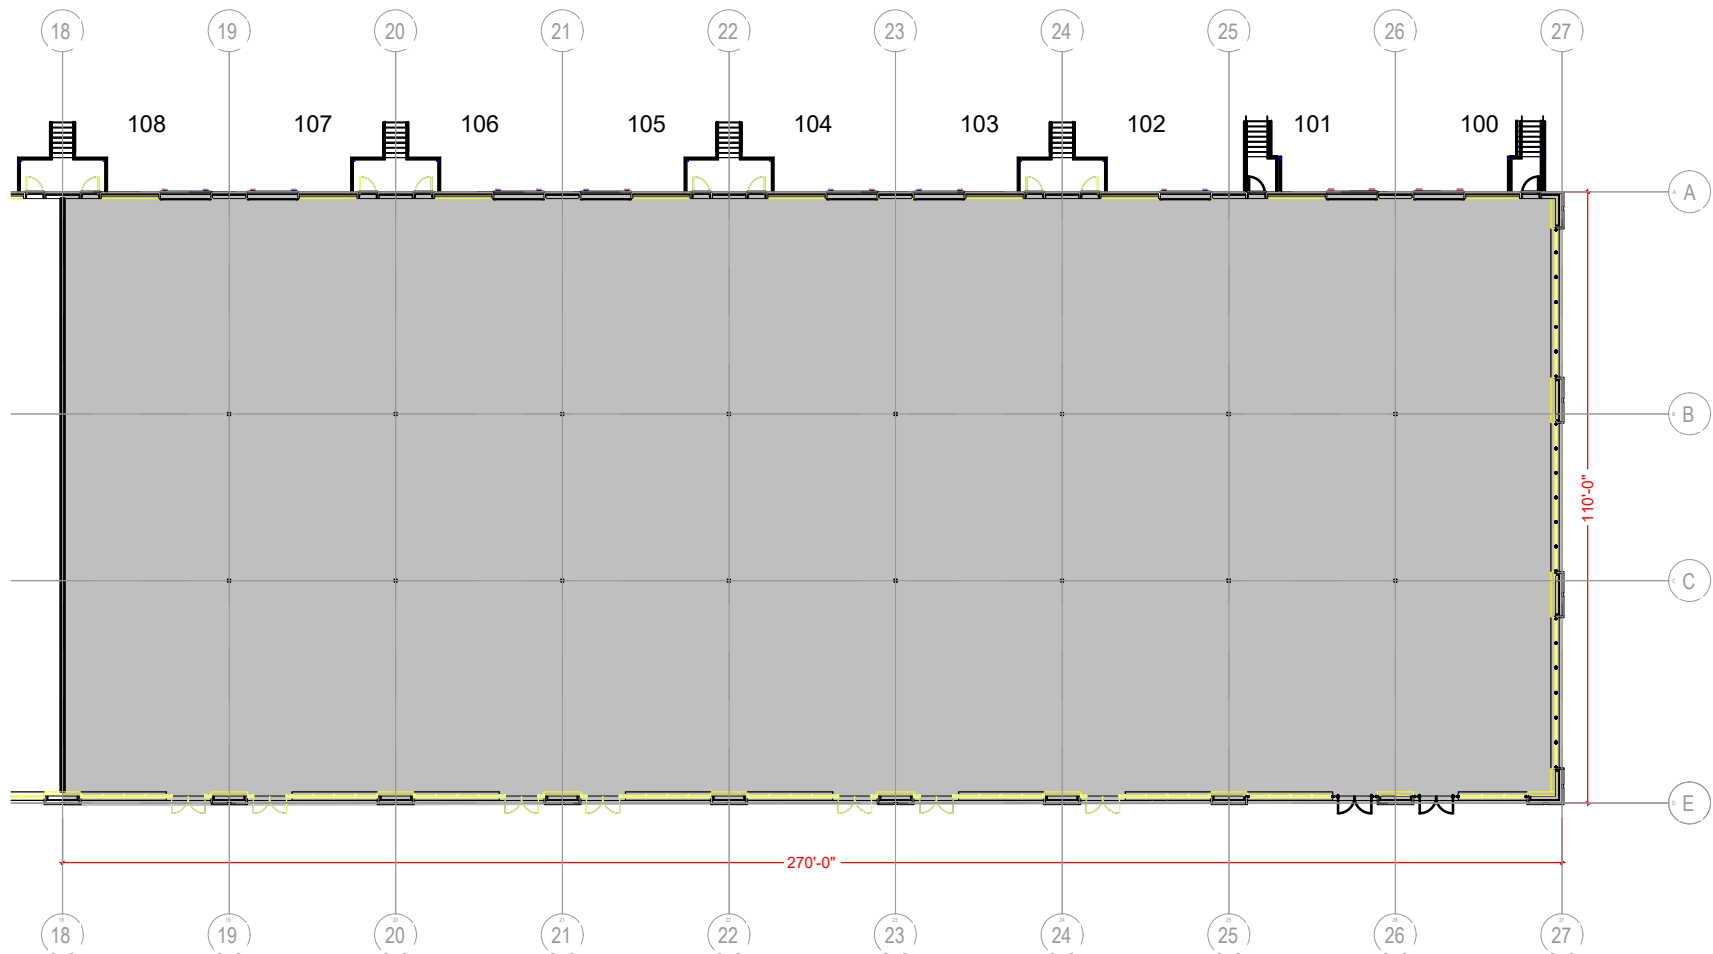

Floor Plan