



TOTAL SF AVAILABLE - 42,922 RSF
* INCLUDED % OF MECH. ROOM

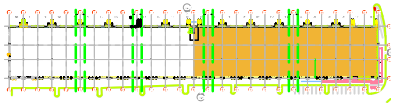

Key Plan

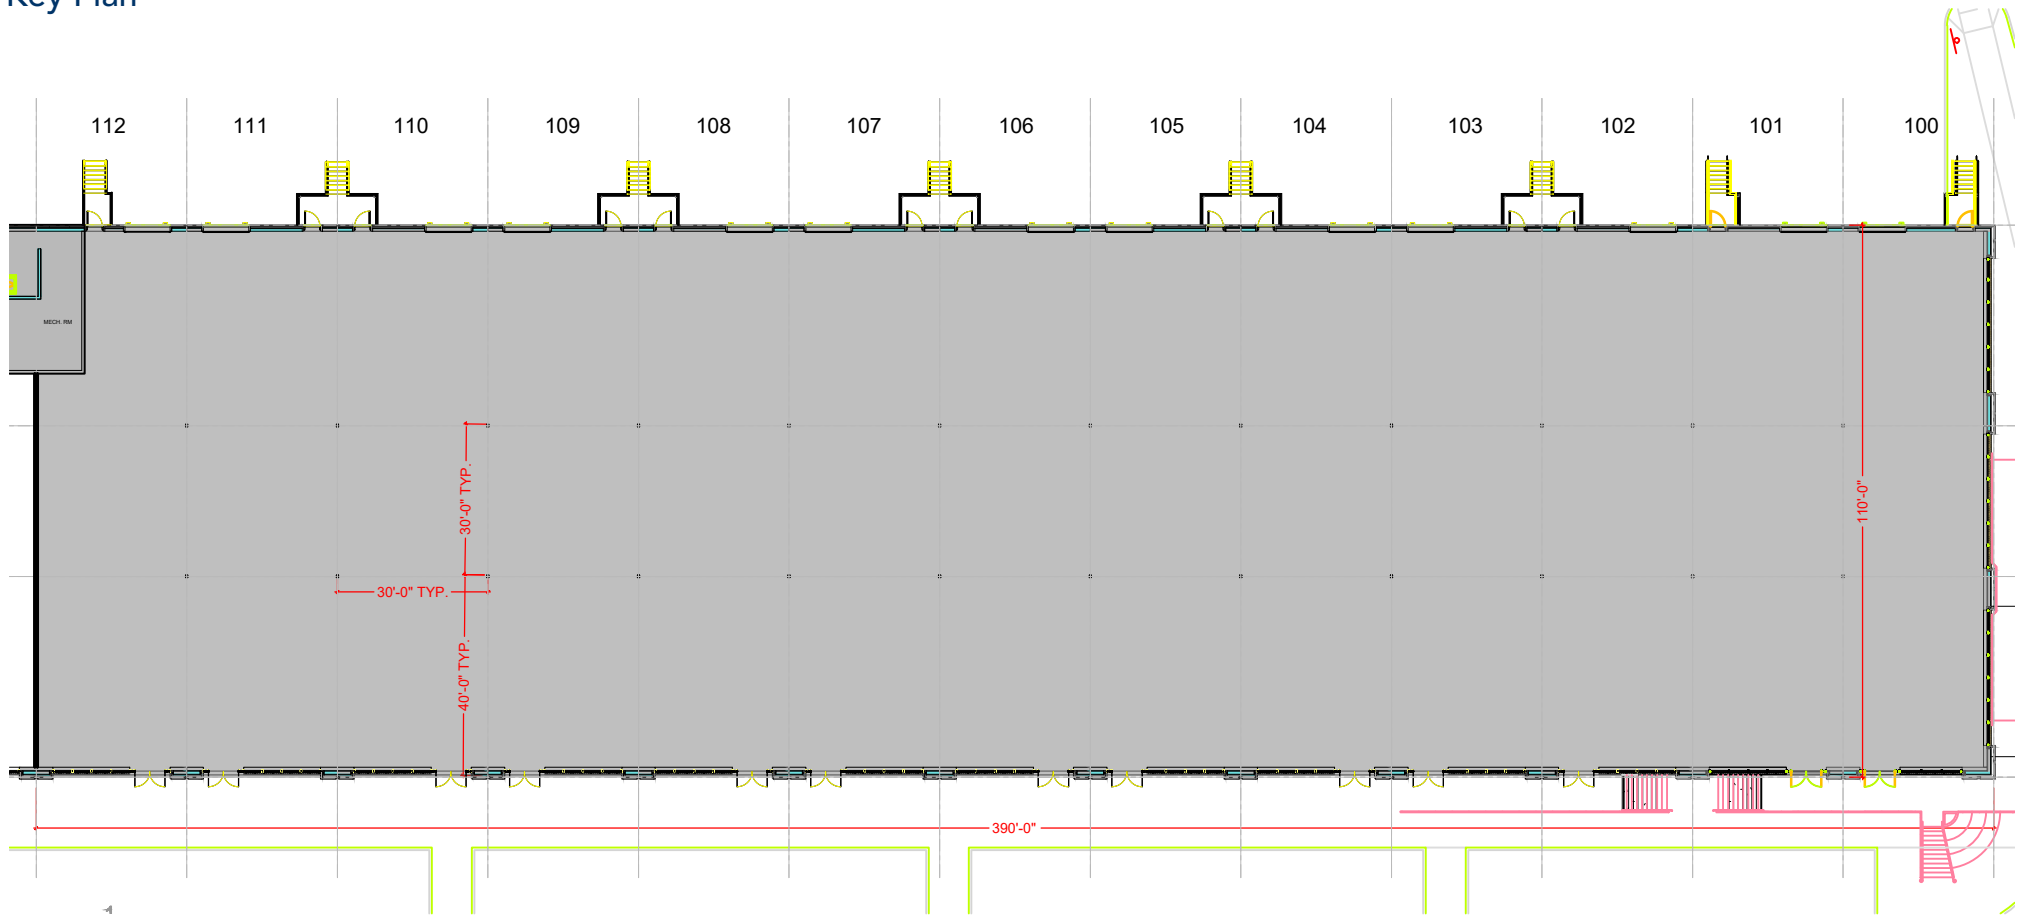

Floor Plan