

TOTAL SF AVAILABLE - 82,800 SF


OFFICE - 0,000 SF

WAREHOUSE - 82,800 SF

[Click to access 3D model](#)



## Key Plan

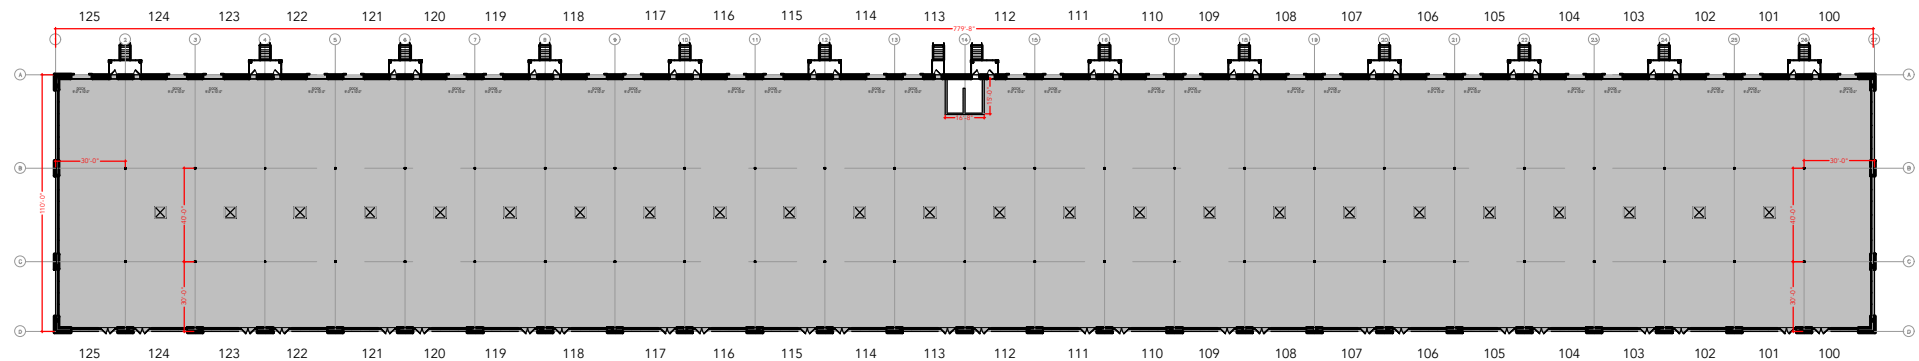

## Floor Plan