



TOTAL SF AVAILABLE - 1,507 RSF

OFFICE - 288 RSF

WAREHOUSE - 1,219 RSF

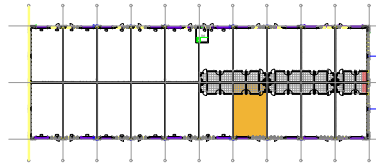

Key Plan

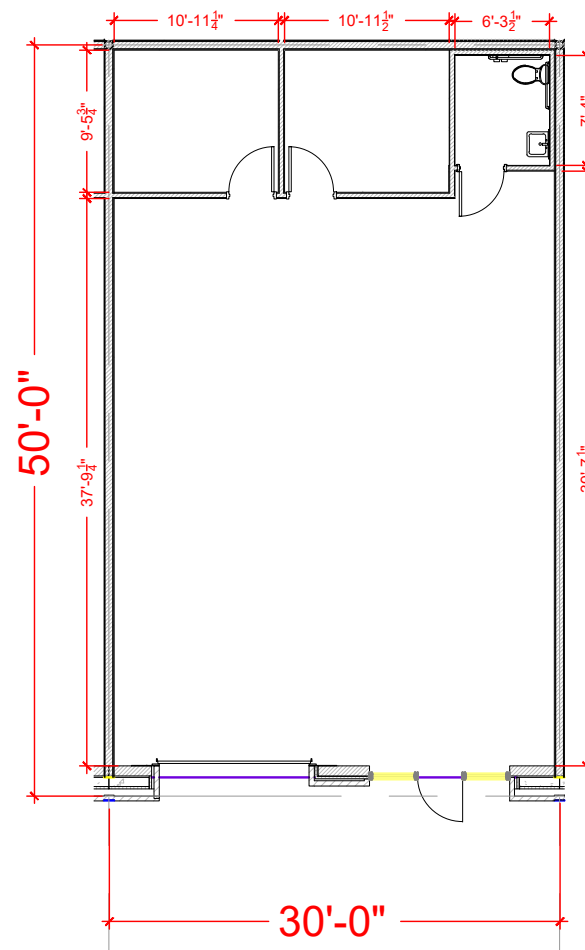

Floor Plan