


TOTAL SF AVAILABLE - 1,507 RSF


OFFICE - 288 RSF

WAREHOUSE - 1,219 RSF

[Click to access CADD file](#)

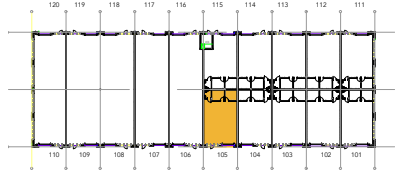

Key Plan

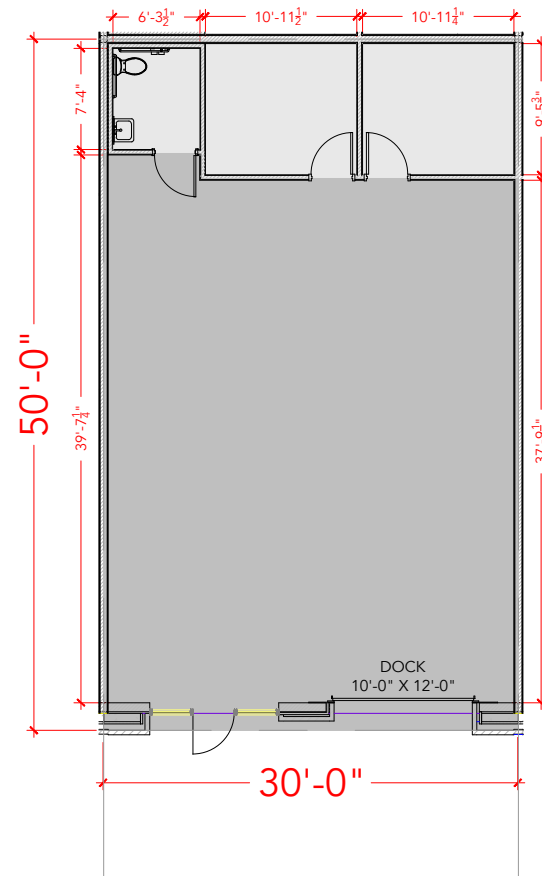

Floor Plan