


Key Plan

TOTAL SF AVAILABLE - 1,507 RSF

OFFICE - 288 RSF

WAREHOUSE - 1,219 RSF

[Click to access 3D model](#)

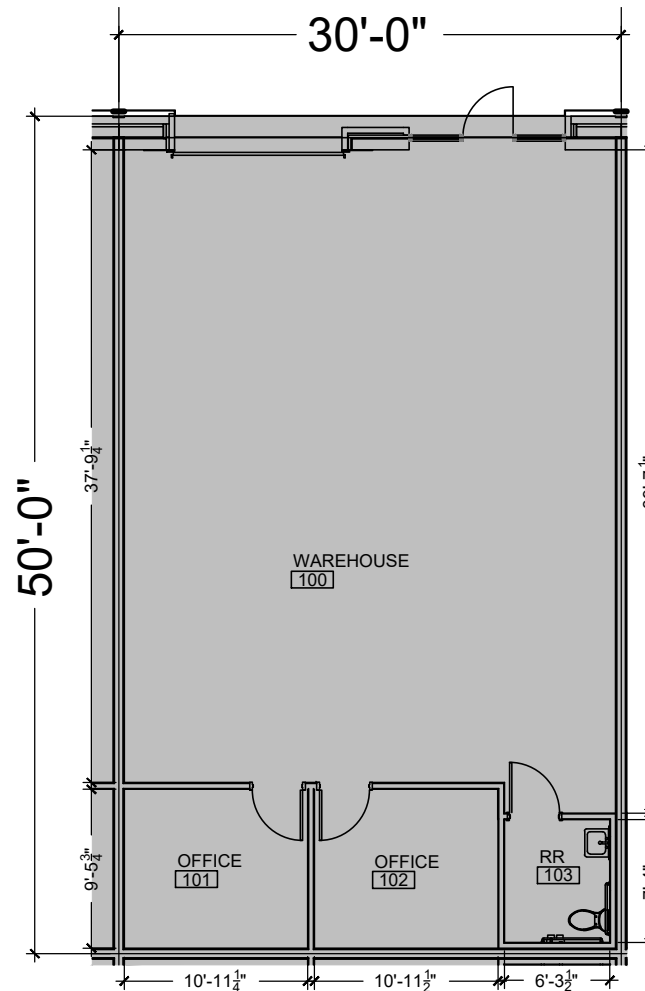

Floor Plan