


**TOTAL SF AVAILABLE - 50,600 SF**


OFFICE - 0,000 SF

WAREHOUSE - 50,600 SF

[Click to access 3D model](#)

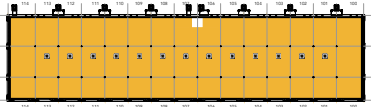

## Key Plan

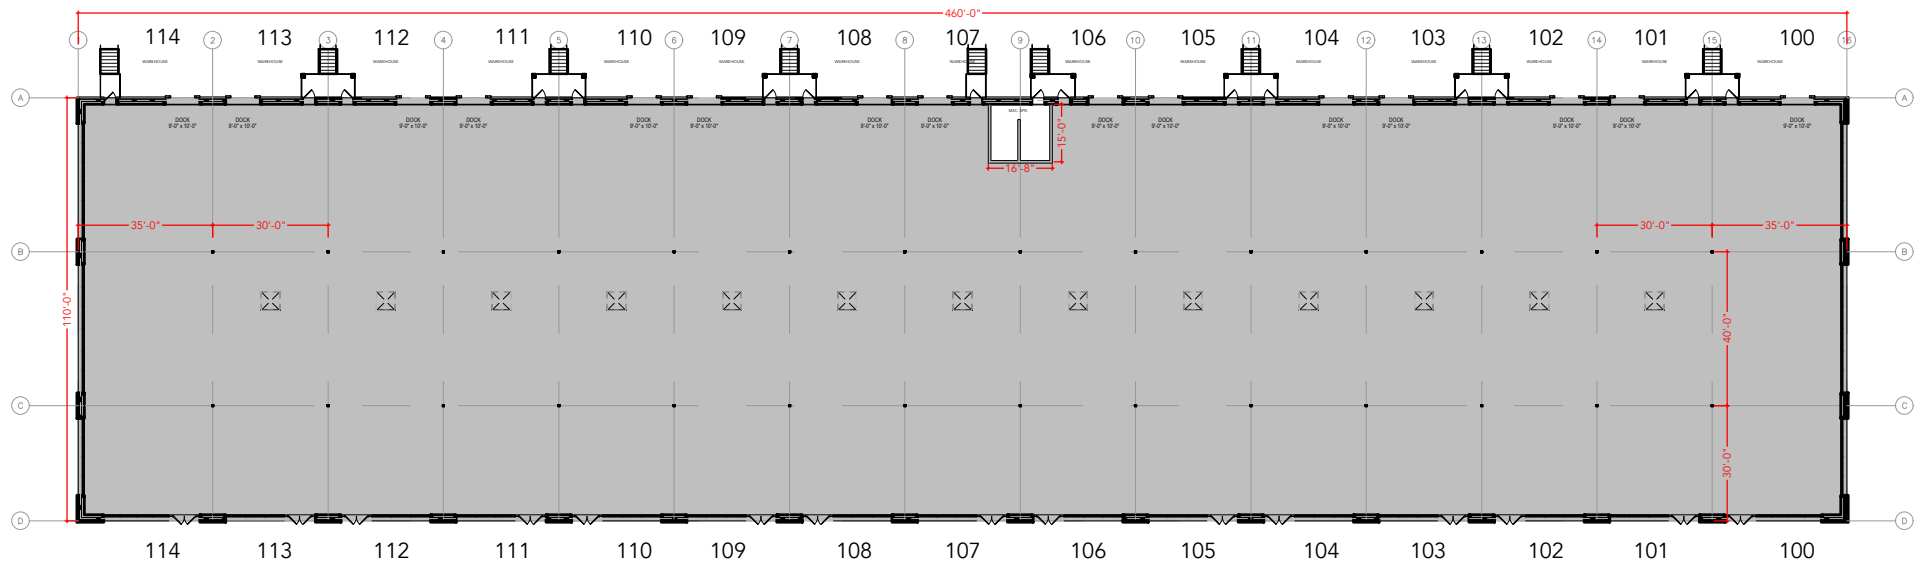

## Floor Plan