



**TOTAL SF AVAILABLE - 47,787 RSF**  
(INCLUDES % OF MECH. RM)

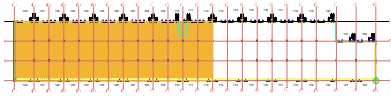

## Key Plan

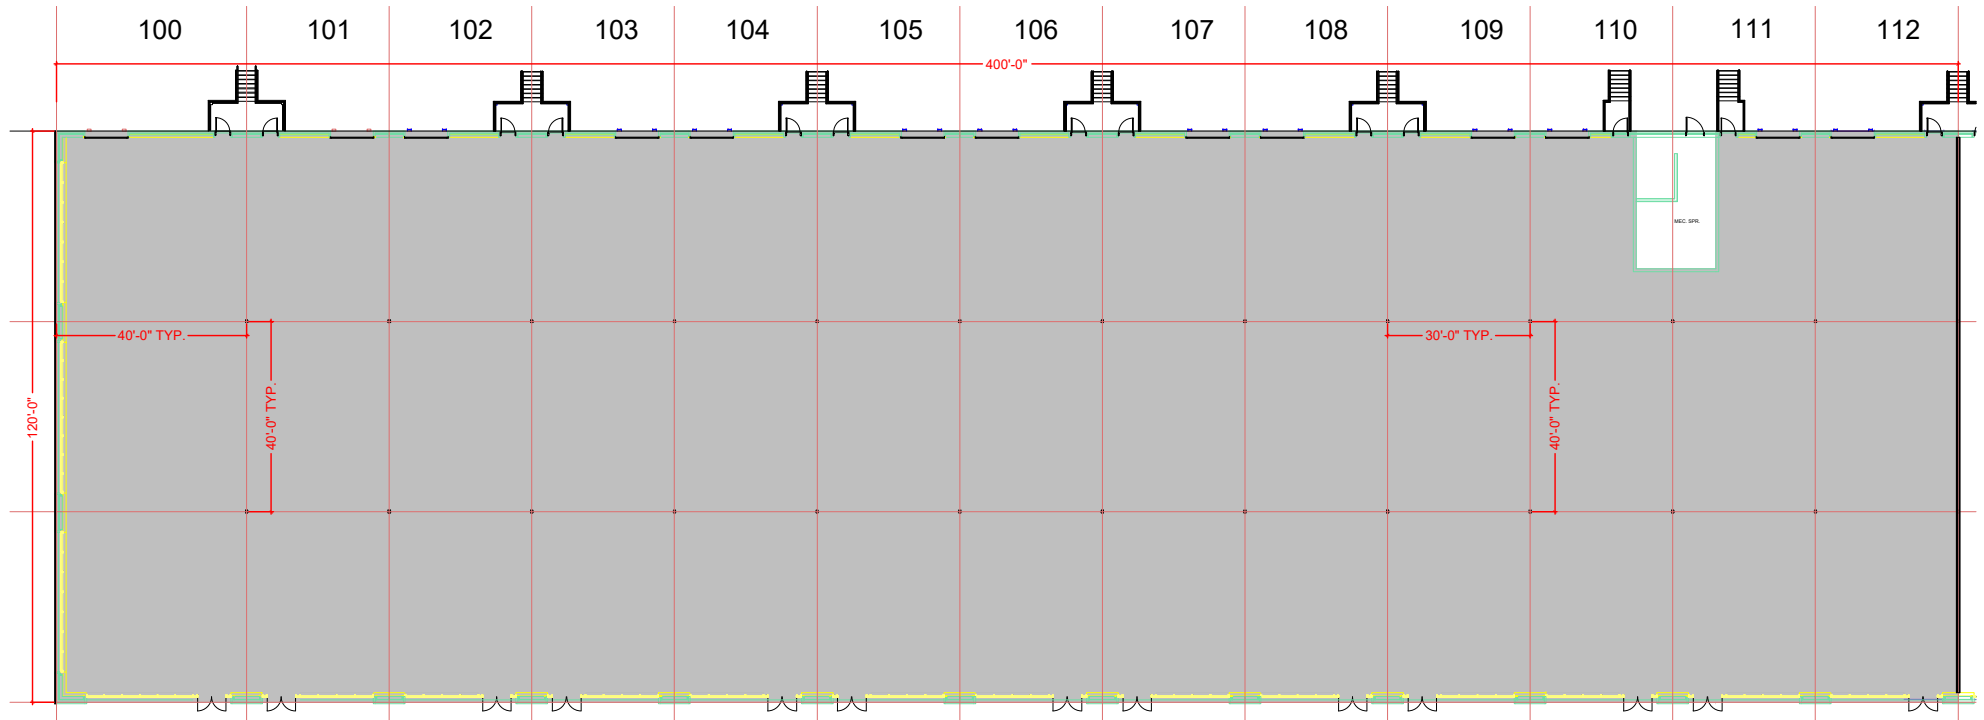

## Floor Plan