



105

106

TOTAL SF AVAILABLE - 7,242 RSF

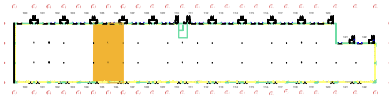

Key Plan

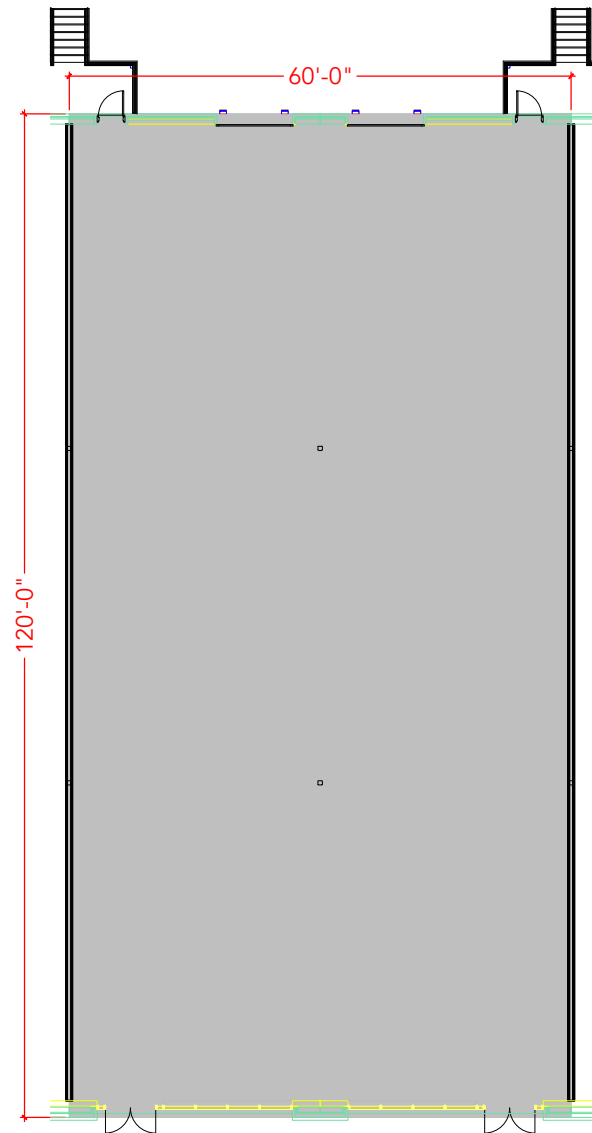

Floor Plan