

Key Plan

TOTAL SF AVAILABLE - 7,242 RSF


OFFICE - 1,989 SF

WAREHOUSE - 5,253 RSF

[Click to access CADD file](#)

Floor Plan

PLAN NOT TO SCALE - THIS IS NOT A CONSTRUCTION DOCUMENT

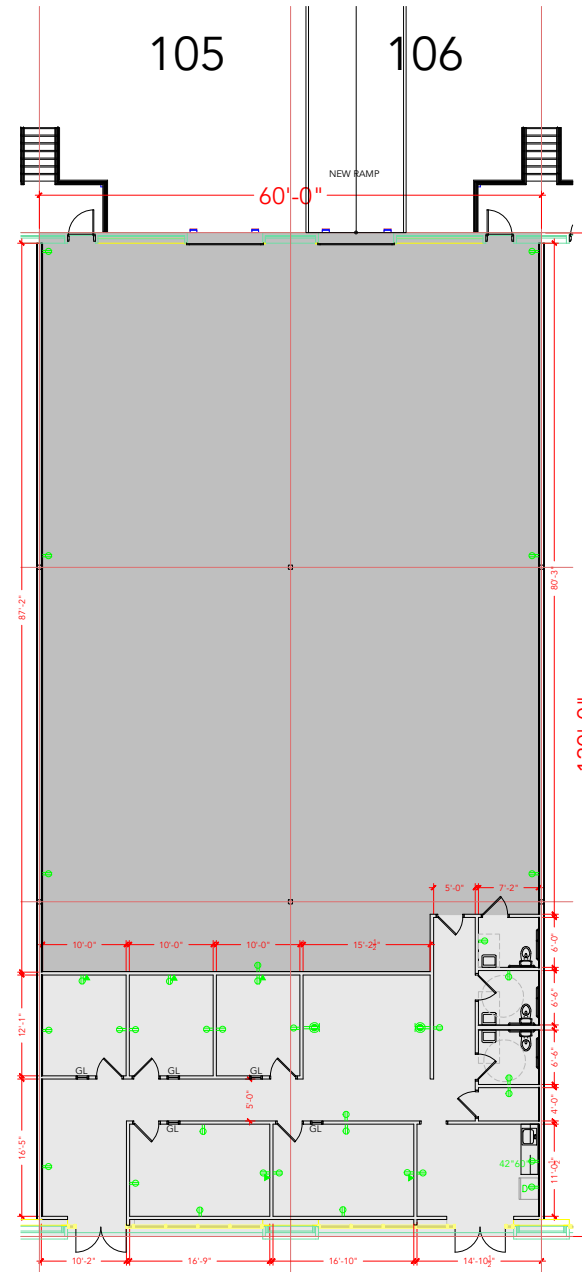

DRAWING #: WF3-D1-105-106 ASBUILT DATE: **NEEDS TO BE**