



TOTAL SF AVAILABLE - 6,976 RSF

(INCLUDES % OF MECH. RM)

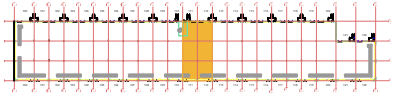

Key Plan

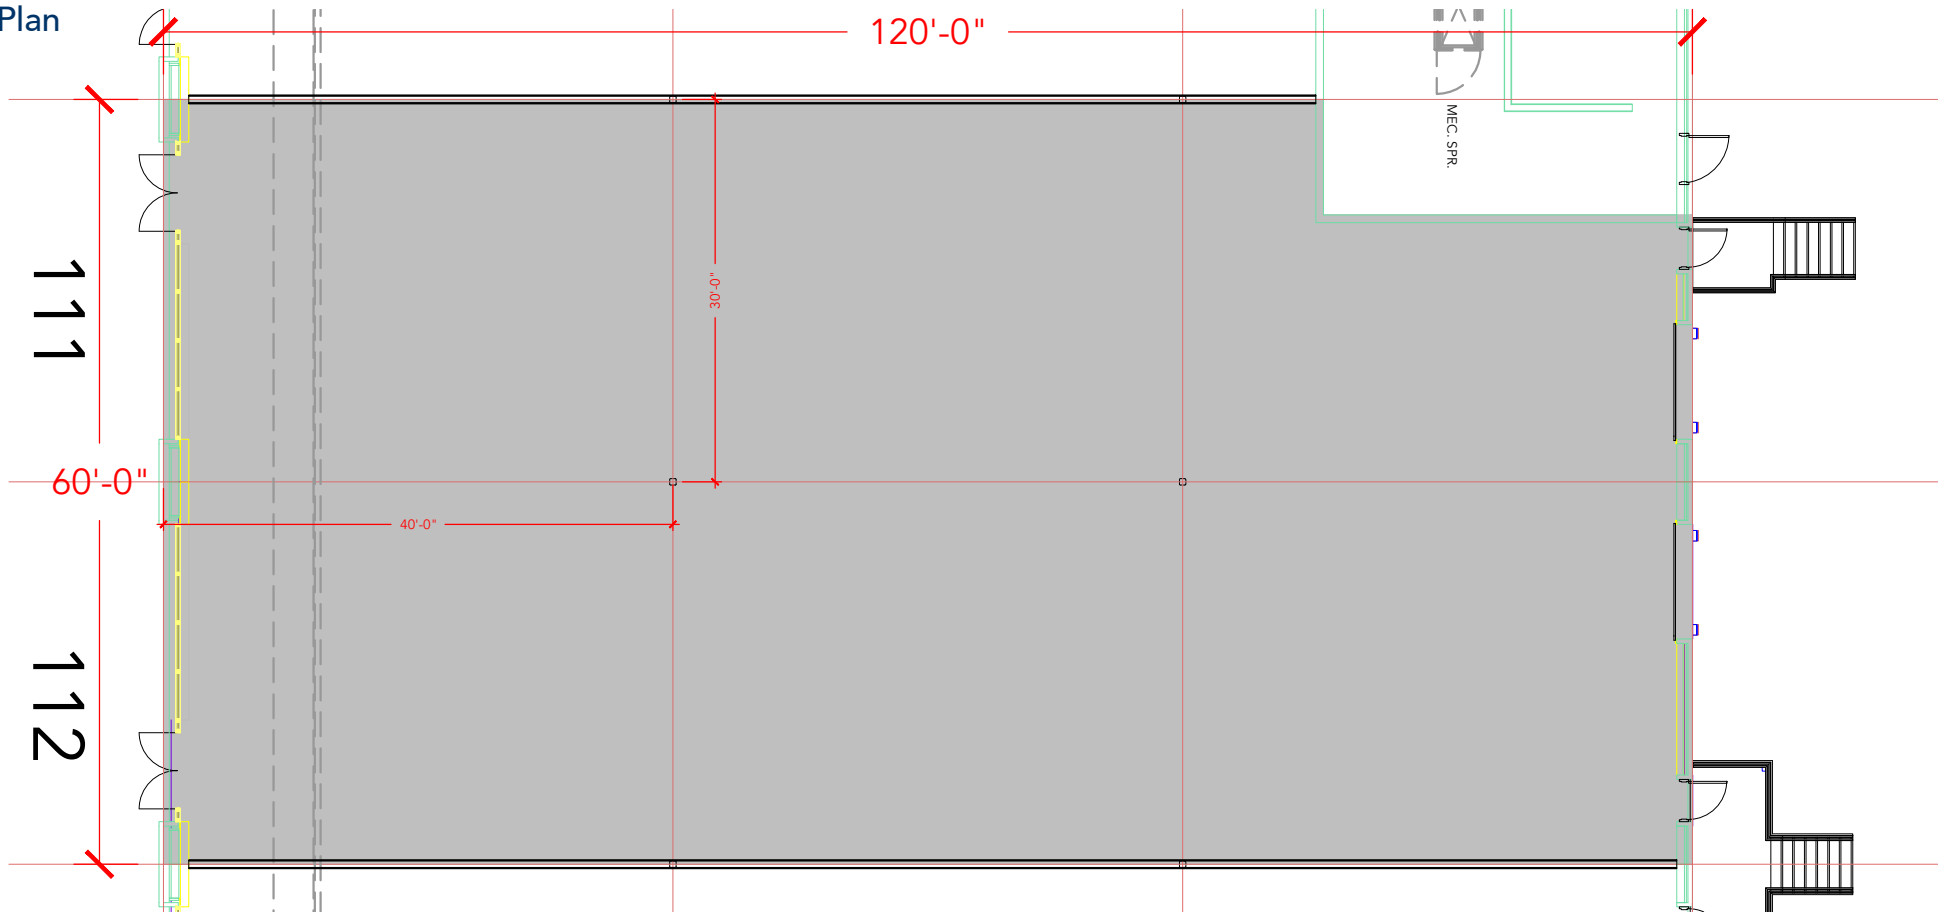

Floor Plan