



TOTAL SF AVAILABLE - 1,812 RSF

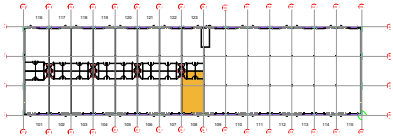

Key Plan

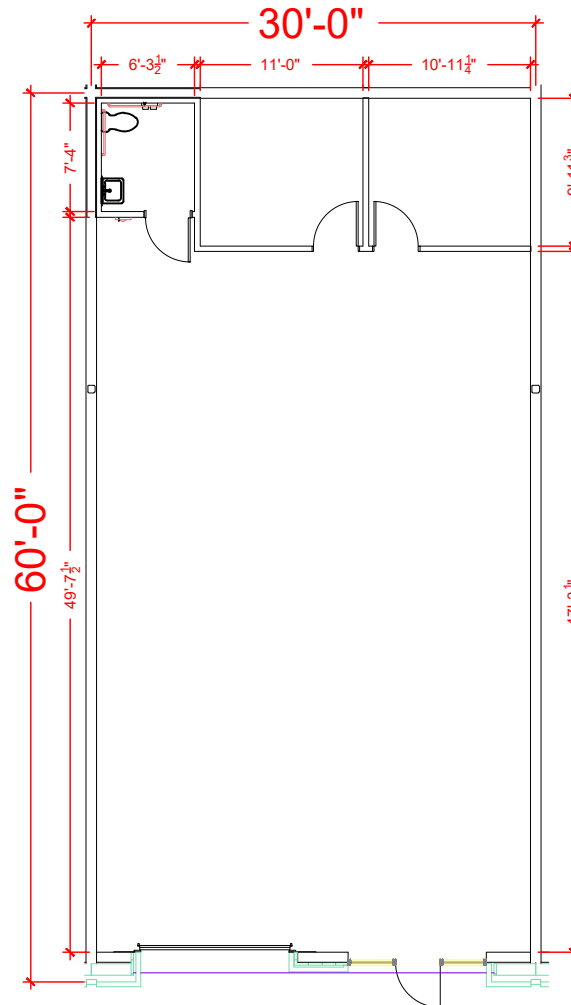

Floor Plan