



TOTAL SF AVAILABLE - 3,346 RSF
(INCLUDES % OF MECH. RM)

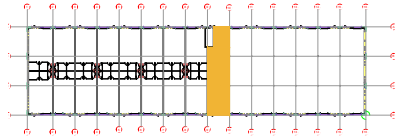

Key Plan

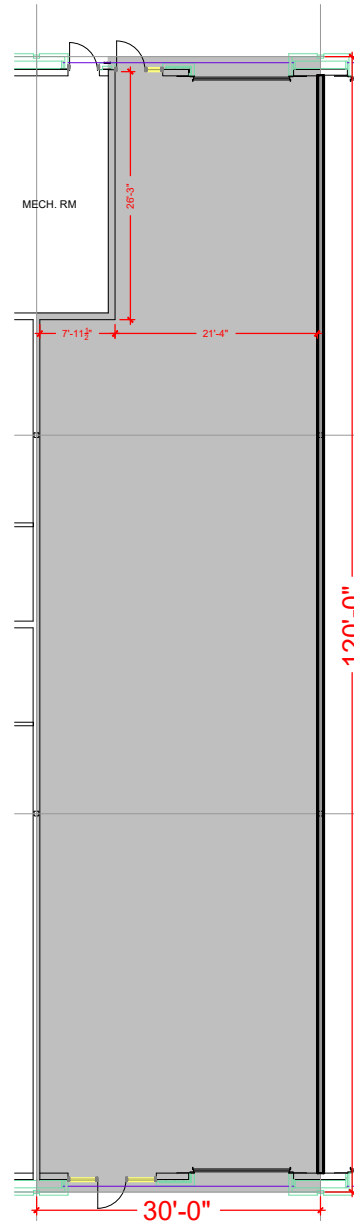

Floor Plan