


TOTAL SF AVAILABLE -1,812 RSF

OFFICE - 300 RSF  
WAREHOUSE - 1,512 RSF

Key Plan

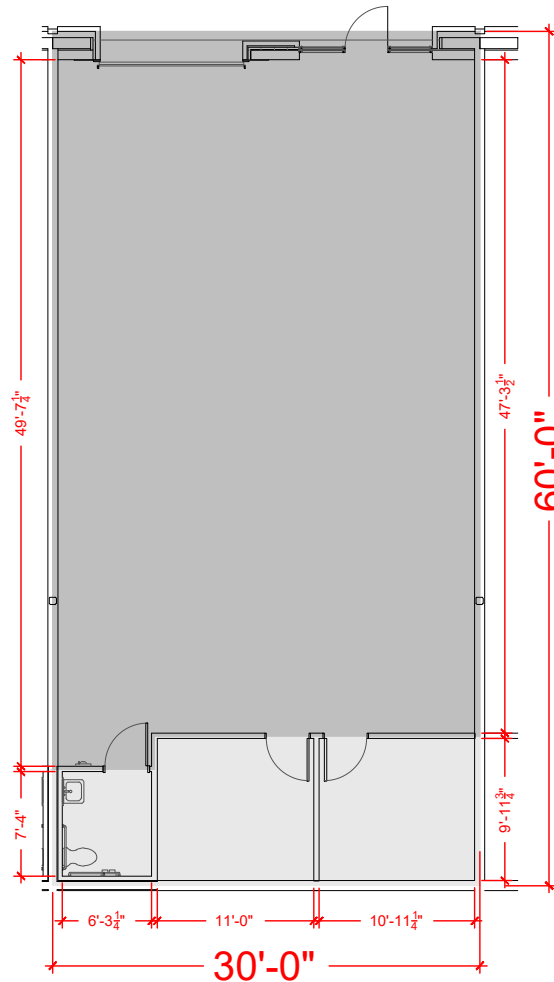

Floor Plan