



TOTAL SF AVAILABLE -1,812 RSF

OFFICE - 300 RSF
WAREHOUSE - 1,512 RSF

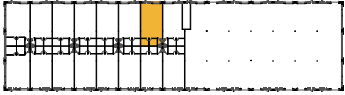

Key Plan

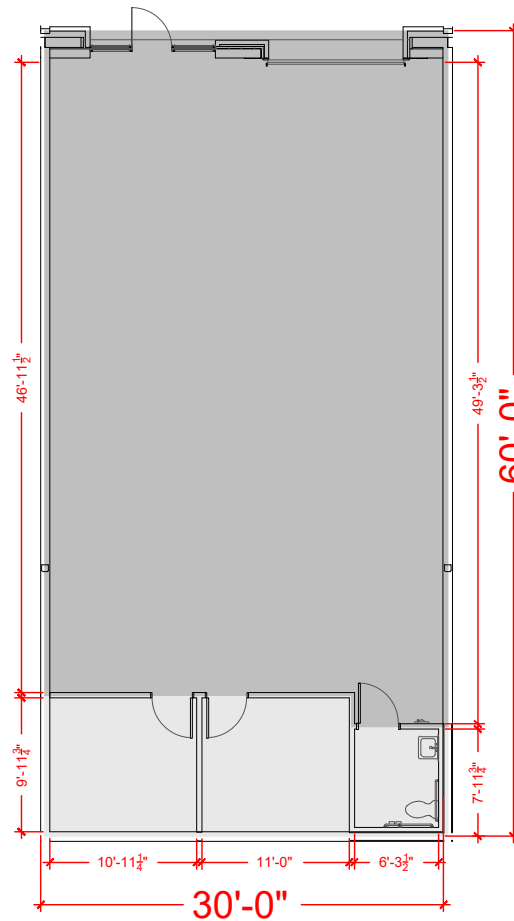

Floor Plan