



TOTAL SF AVAILABLE - 1,715 RSF

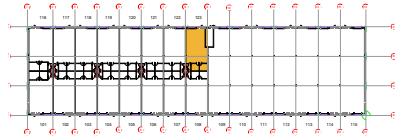

Key Plan

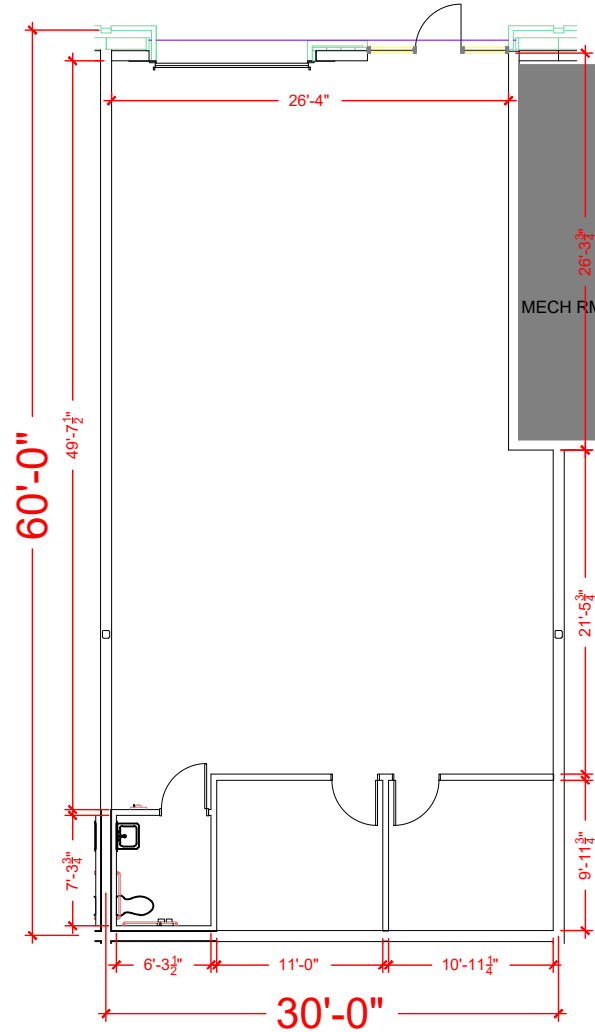

Floor Plan