




TOTAL SF AVAILABLE - 55,200 SF

OFFICE - 0,000 SF

WAREHOUSE - 55,200 SF

[Click to access 3D model](#)

Key Plan

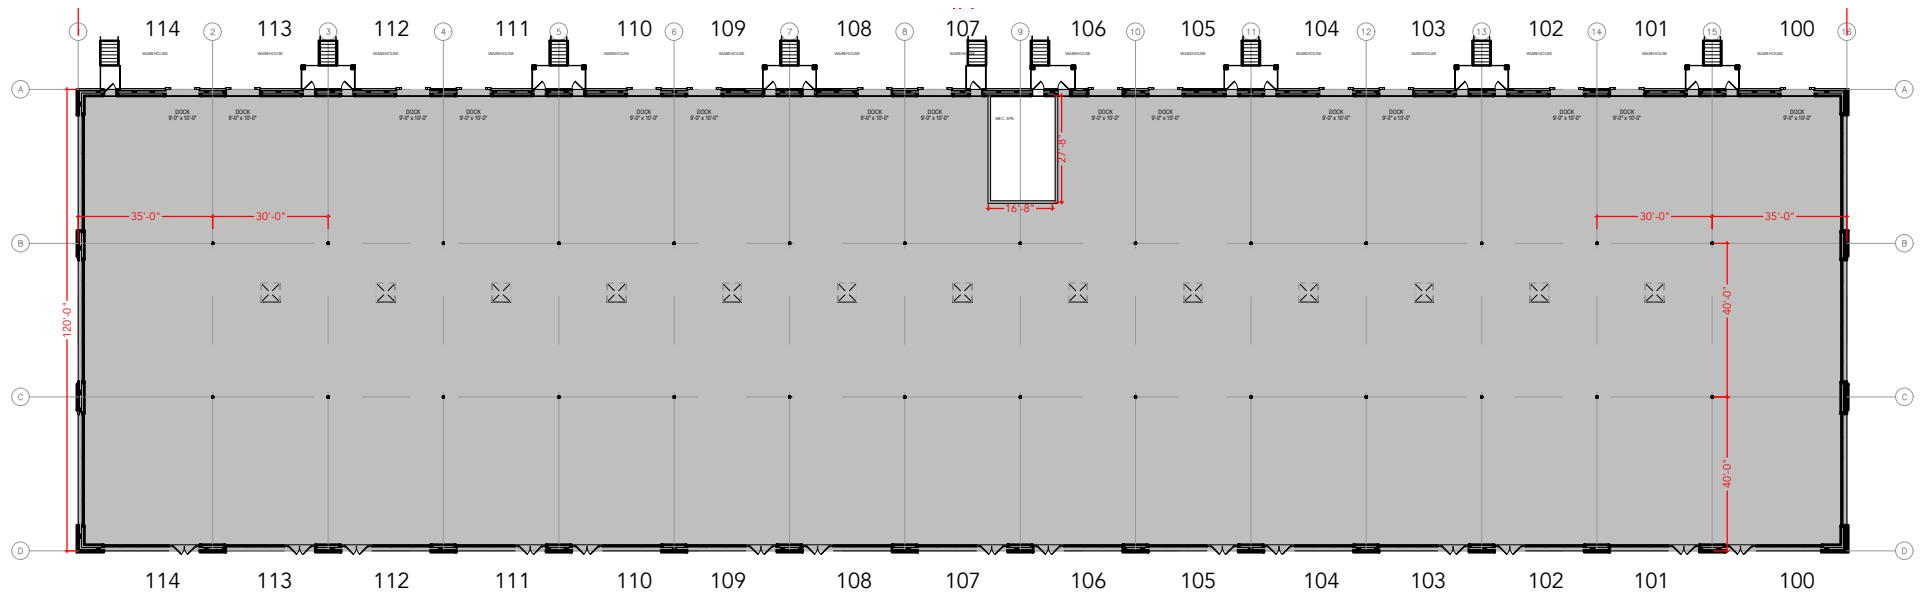

Floor Plan