


**TOTAL SF AVAILABLE - 67,800 SF**


**OFFICE - 0,000 SF**

**WAREHOUSE - 67,800 SF**

[Click to access 3D model](#)

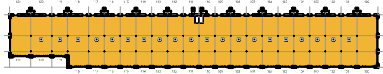

## Key Plan

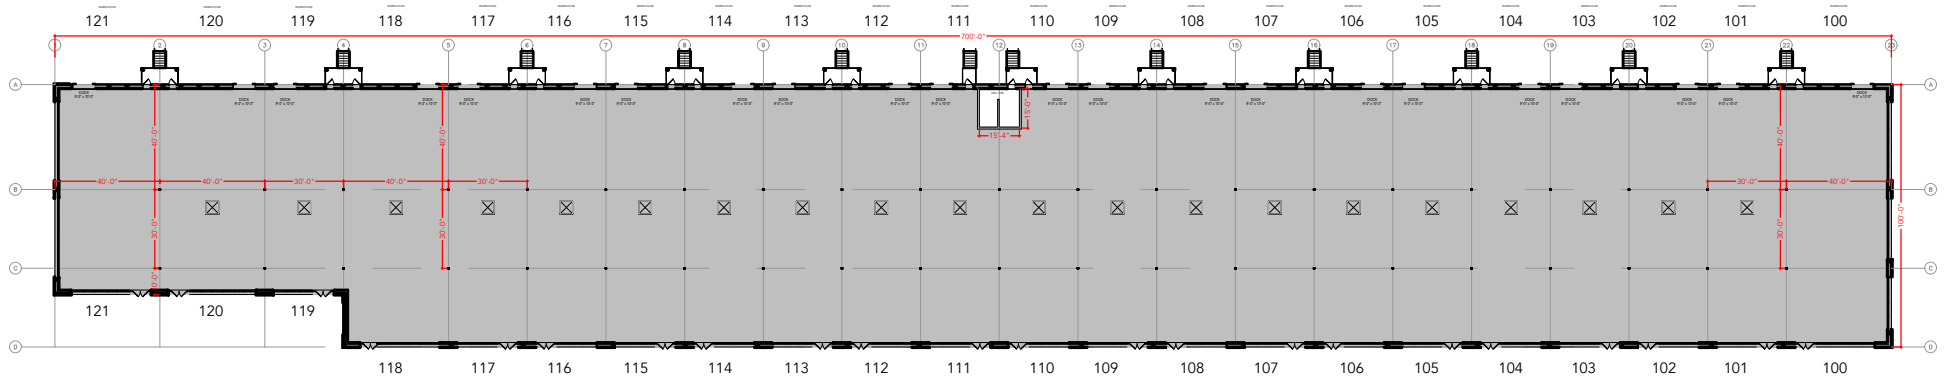

## Floor Plan