

TOTAL SF AVAILABLE - 67,800 SF


OFFICE - 0,000 SF

WAREHOUSE - 67,800 SF

[Click to access 3D model](#)



Key Plan

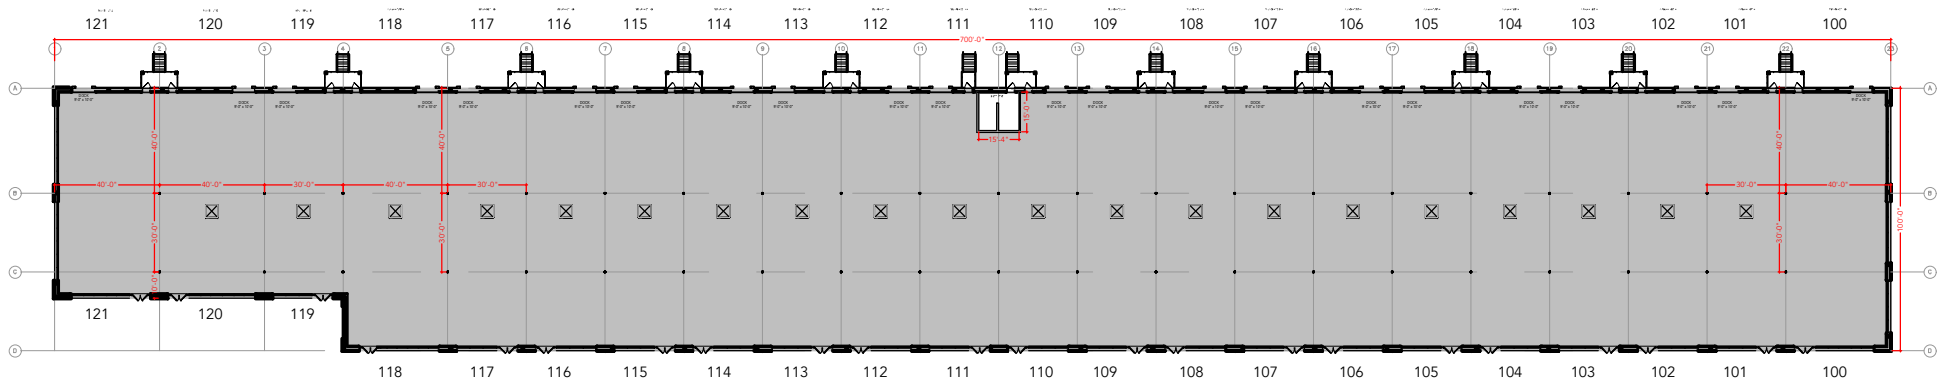

Floor Plan