


TOTAL SF AVAILABLE - 72,000 SF


OFFICE - 0,000 SF

WAREHOUSE - 72,000 SF

[Click to access 3D model](#)

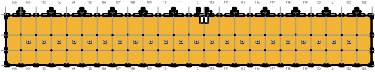

## Key Plan

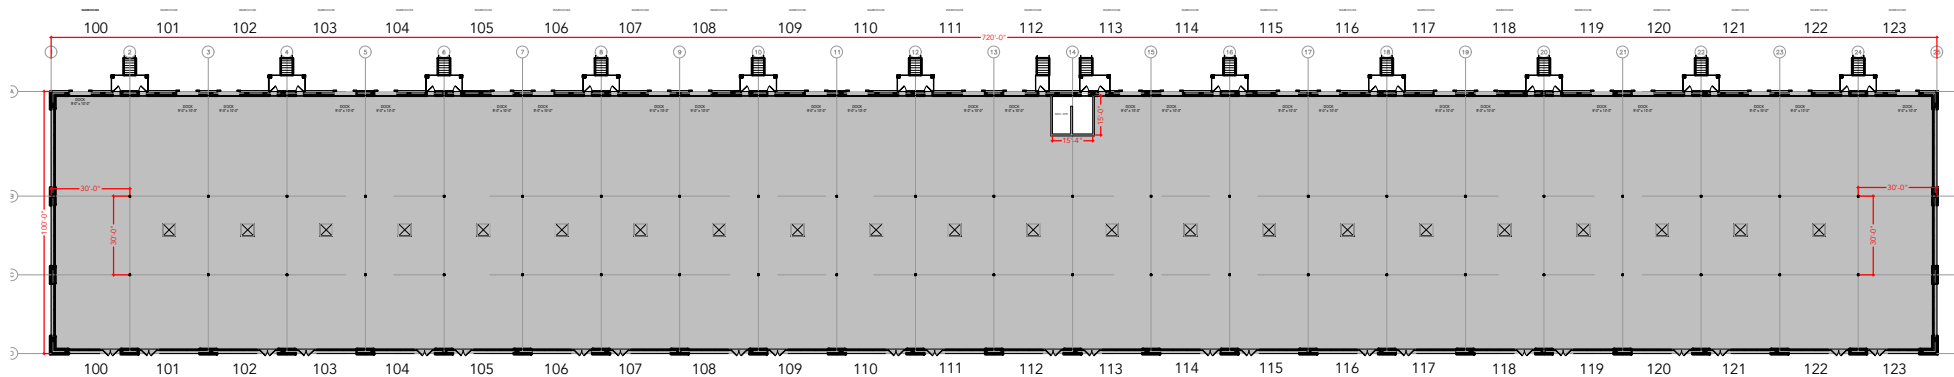

## Floor Plan