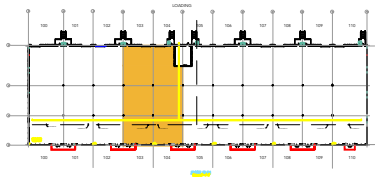
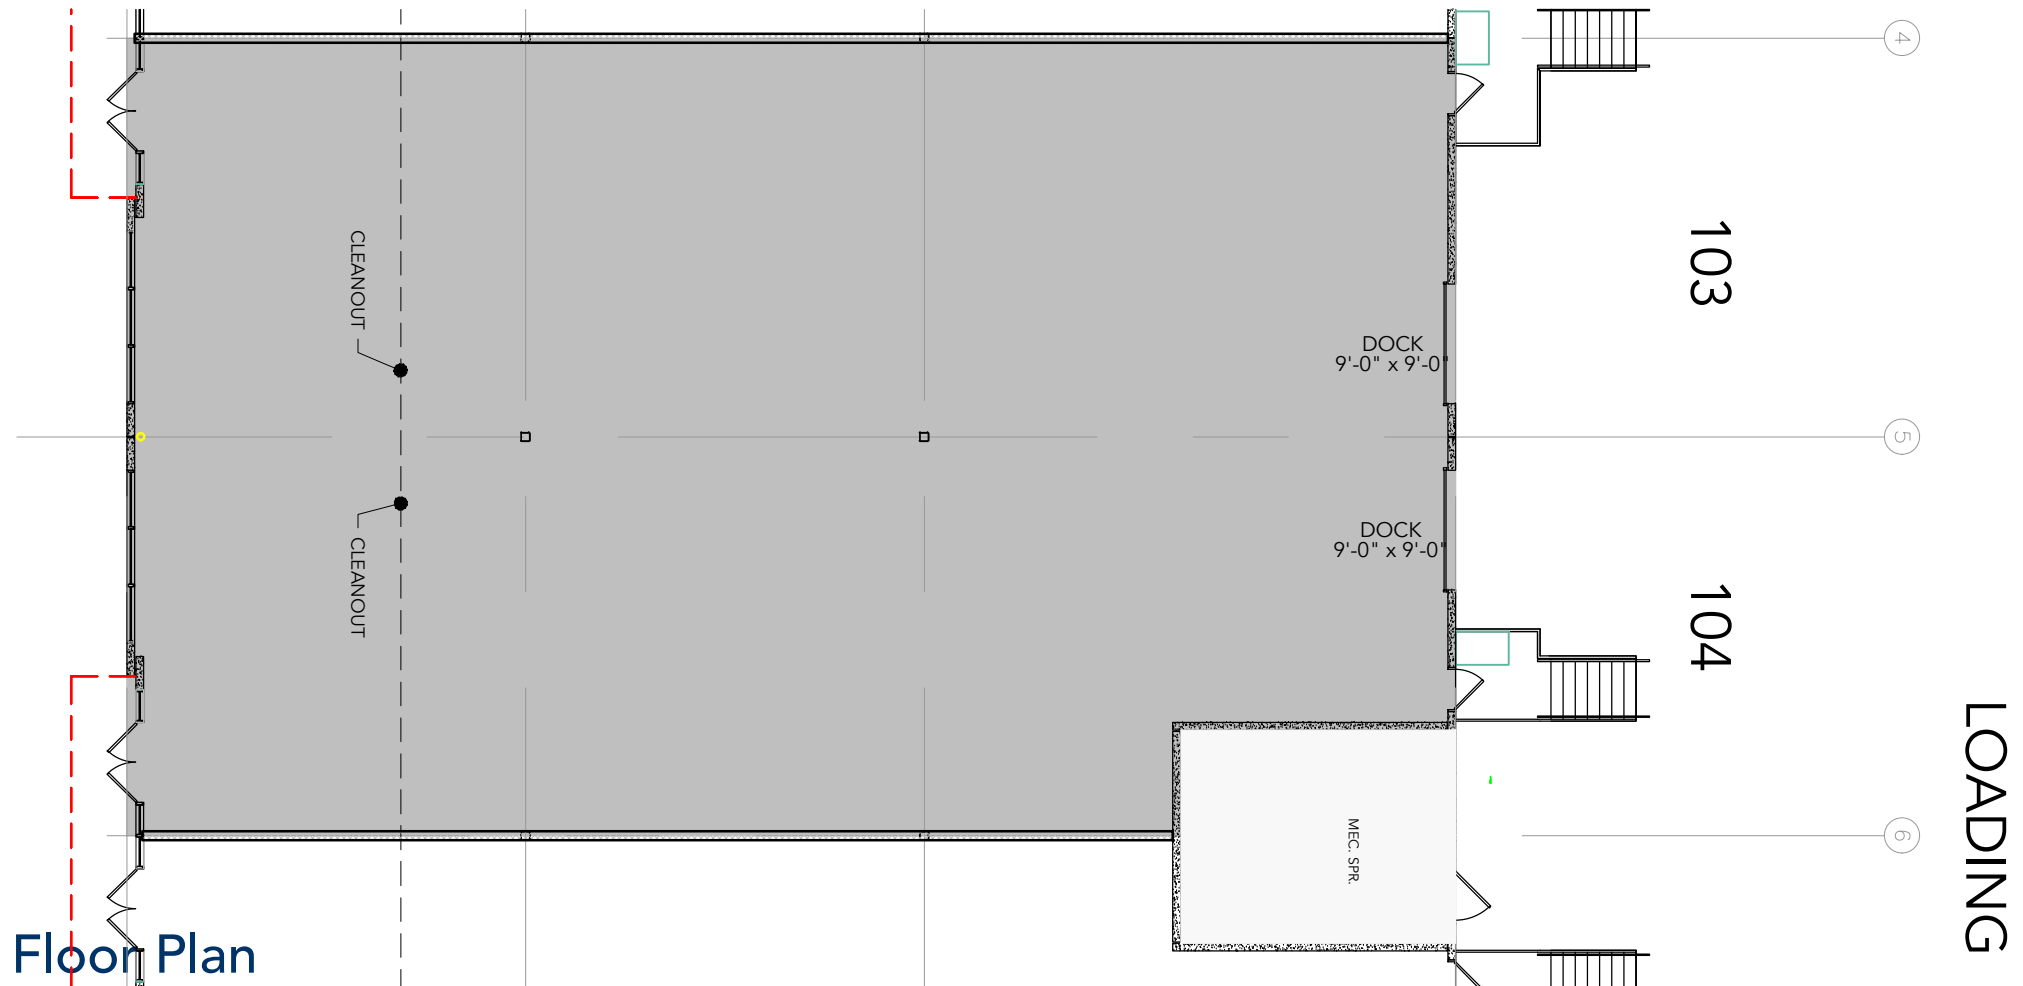


TOTAL SF AVAILABLE -5,893 RSF**OFFICE - 0 RSF****WAREHOUSE - 5,893 RSF**

* INCLUDES % OF METER ROOM

[Click to access CADD file](#)**Key Plan****Floor Plan**